

FINAL PROOF SURVEY

UNDER

APPLICATION No. G-14139

PERMIT No. G-12871

IN NAMES OF


BENNIE L. MACHADO, CLAIR CARLTON AND ROBERT LEWIS

SURVEYED SEPT. 10, 1999

RECEIVED


SEP 30 1999

WATER RESOURCES DEPT.
SALEM, OREGON

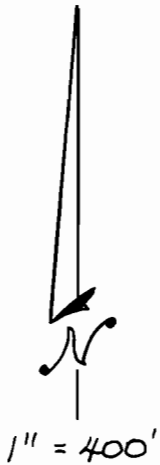

T39S
R7E R8E

W.M.

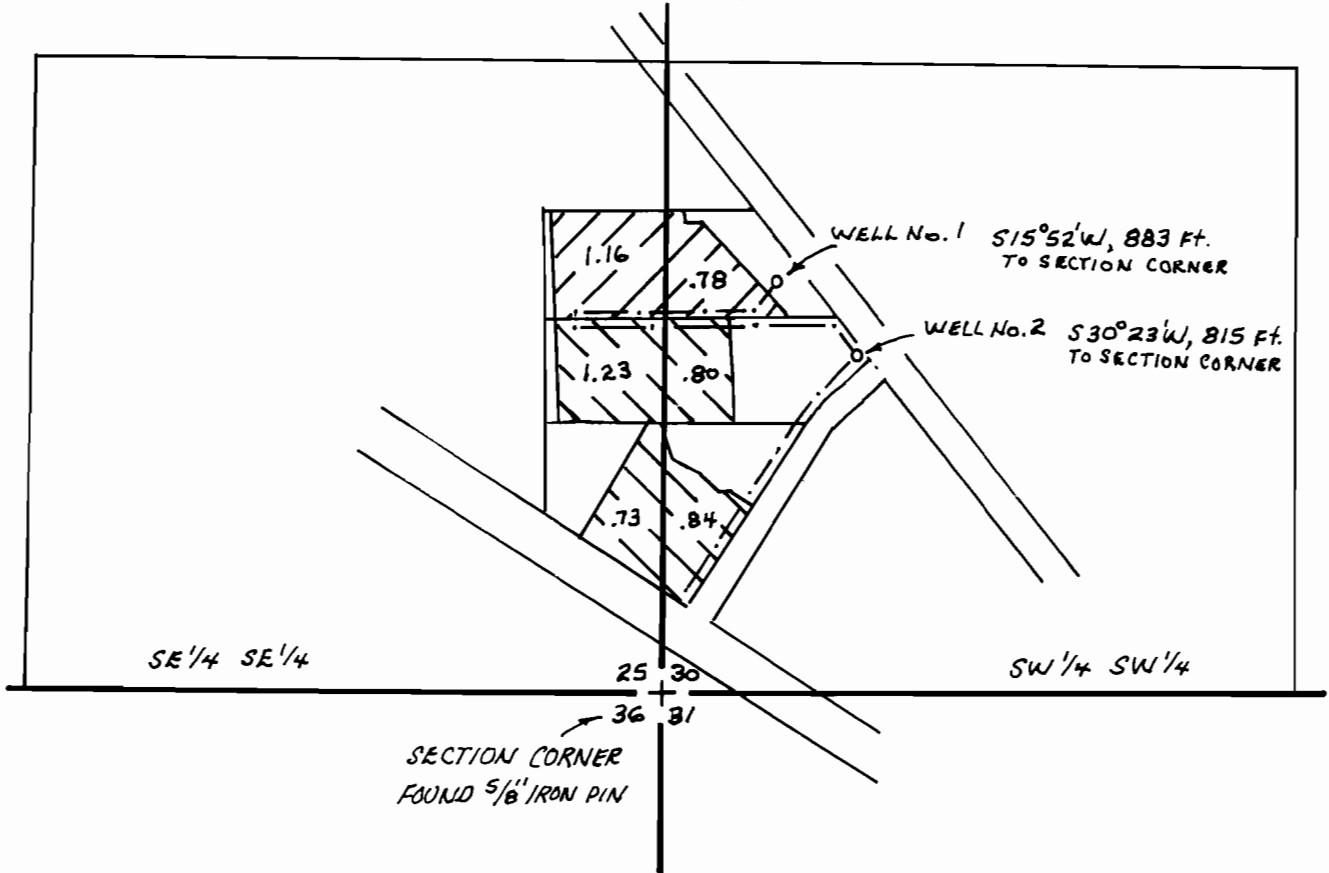

THIS MAP WAS PREPARED TO IDENTIFY THE WATER RIGHT AND SHOULD NOT BE USED TO DETERMINE PROPERTY BOUNDARIES.

#240
Donald L. Gural
EXPIRES 6/30/2001