


RECEIVED

JUN 03 1997

WATER RESOURCES DEPT
SALEM, OREGON

T.5S., R.1W., W.M.

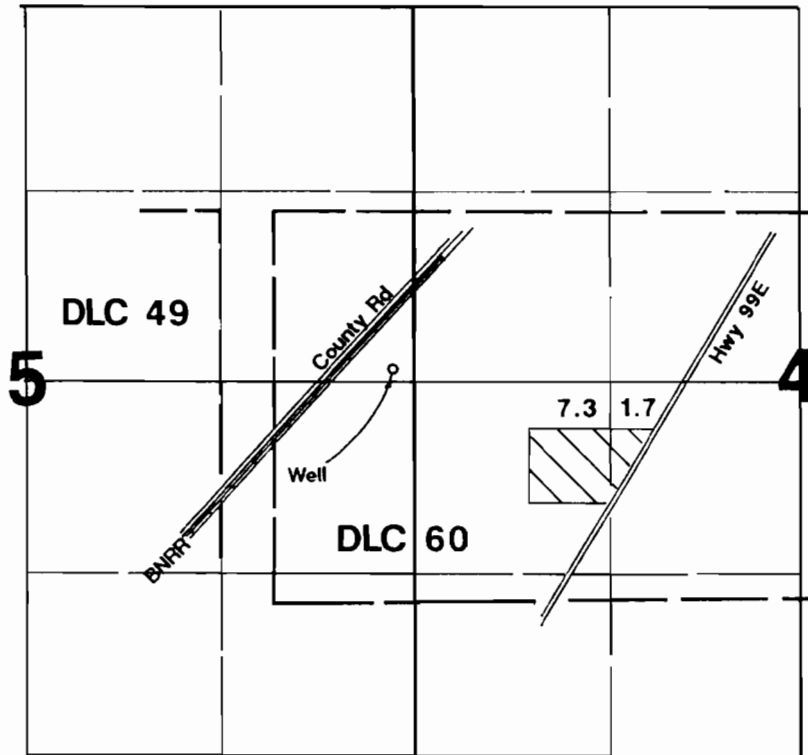

Well located 90'N & 120'W from E $\frac{1}{4}$ corner Section 4.

Final Proof Survey

Application #: G-14072 Permit #: G-12874

In Name Of

Lucy O'Neal

Surveyed on May 10, 1997 by JM Schuette

THIS MAP WAS PREPARED FOR THE PURPOSE OF IDENTIFYING THE LOCATION OF A WATER RIGHT ONLY AND IS NOT INTENDED TO PROVIDE LEGAL DIMENSIONS OR LOCATION OF PROPERTY OWNERSHIP LINES.

