

EXIST PERMIT G-11072
 EXIST APPL. G-11925
 EXIST. WELL LOCATION
 792' N65°22'35"W

EXIST PERMIT G-11325
 EXIST APPL. G-12255


EXISTING WELL: PERMIT G-11325 (APPL. G-12255)
 WELL #1 IS LOCATED 720' WEST AND 330' NORTH
 OF THE EAST 1/4 COR. OF SEC. 27, T1S, R4E WM

EXISTING #2: SUPPLEMENTAL TO PERMIT WELL
 WELL #2 IS LOCATED 1600' WEST AND 600' NORTH
 OF THE EAST 1/4 CORNER OF SEC. 27, T1S, R4E
 WM, CLACKAMAS COUNTY, OREGON (LOCATED IN THE
 SE 1/4 OF NE 1/4 OF SAID SECTION 27).

PREPARATION OF THIS MAP WAS FOR THE PURPOSE
 OF IDENTIFYING THE LOCATION OF THE WATER RIGHTS
 ONLY AND HAS NO INTENT TO PROVIDE DIMENSIONS
 OR LOCATION OF PROPERTY OWNERSHIP LINES.


FINAL PROOF SURVEY
GROUNDWATER PERMIT G-12881

PREPARED BY EDWARD A. CRANE, CWRE

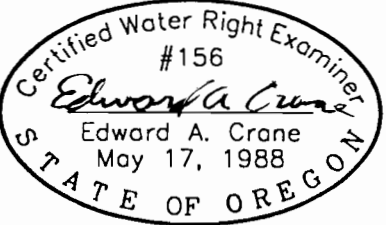

Renewal 12/31/99
 Signed *E. A. Crane*

SURVEYED AUG. 20, 1999
 BY EDWARD A. CRANE, CWRE

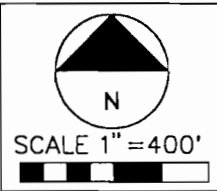

DATE
 AUG. 1999

PROJECT NO.
 165-002



CRANE & MERSETH
 Engineering/Surveying
 SUITE "D"
 6566 SE LAKE ROAD
 MILWAUKIE, OREGON 97222
 BUS: (503) 654-2005
 FAX: (503) 654-2575

APPLICATION FOR PERMIT NUMBER G-14156
 PERMIT NUMBER G-12881 IN THE NAME OF:
 RICHARD SURFACE dba SURFACE NURSERY INC.
 33740 SE LUSTED RD., GRESHAM, OR 97080

SHEET
 1/1