

RECEIVED

OCT - 3 1994  
WATER RESOURCES DEPT.  
SALEM, OREGON


# DESCHUTES RIVER WOODS

WELL #1: 1800 FT. E. AND 70 FT. S. FROM NW 1/4 CORNER OF SW 1/4 SECTION 25 (T18S, R11E)  
 WELL #2: 1800 FT. E. AND 110 FT. S. FROM NW 1/4 CORNER OF SW 1/4 SECTION 25 (T18S, R11E)  
 WELL #3: 130 FT. E. AND 110 FT. S. FROM NE 1/4 CORNER OF NW 1/4 SECTION 36 (T18S, R11E)  
 WELL #4: 180 FT. E. AND 110 FT. S. FROM THE NE 1/4 CORNER OF THE NW 1/4 SEC. 36, T.18S, R.11E



T.18S.  
T.19S.

82  
164  
1.8  
NUMBER OF LOTS  
G.P.M.  
HEAD LOSS IN FEET

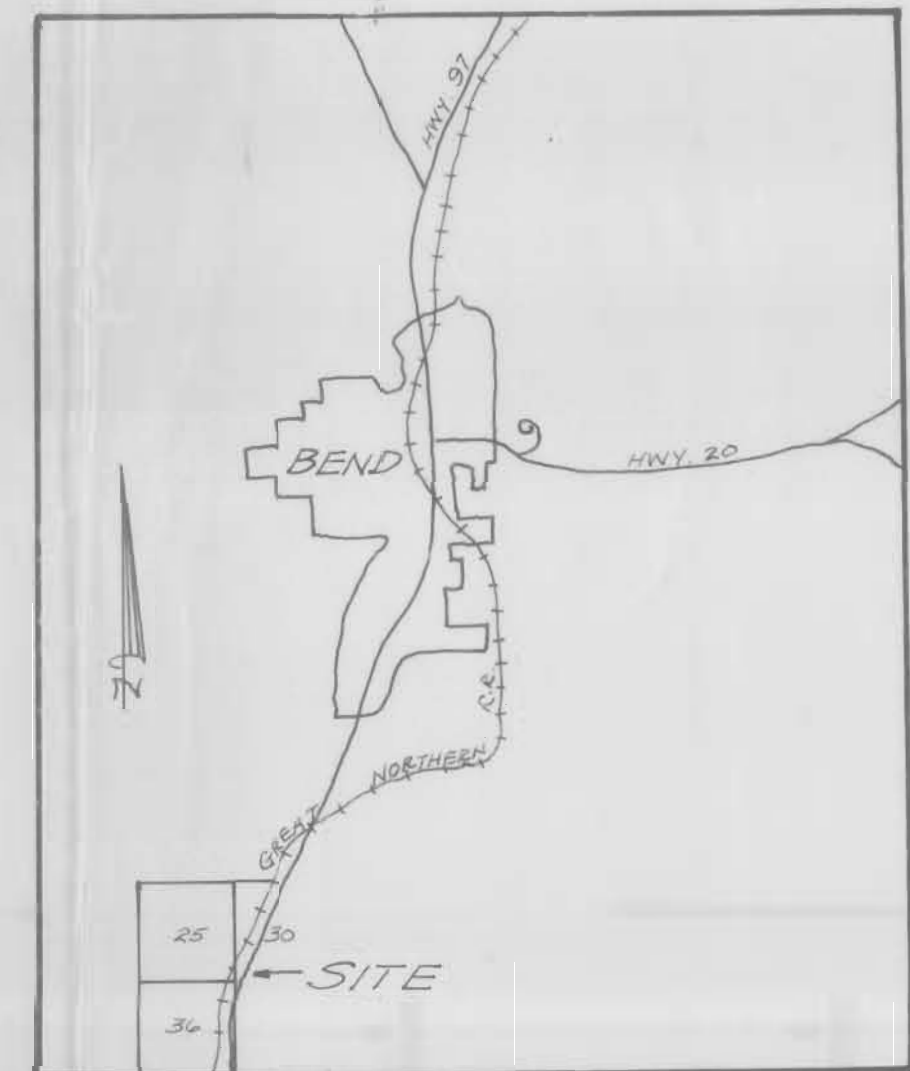


VICINITY MAP  
Scale: 1/2" = 1 mile

TOTAL IRRIGATED ACRES = 93 ACRES

**SOURCE OF SUPPLY**  
 Well No. 1 320 G.P.M. (Presently 40 G.P.M.)  
 Well No. 2 160 G.P.M. (Presently 90 G.P.M.)  
 Well No. 3 180 G.P.M.  
 WELL No. 4 450 G.P.M.

**STORAGE CAPACITY**  
 Reservoir No. 1 30,000 Gallons  
 Reservoir No. 2 30,000 Gallons

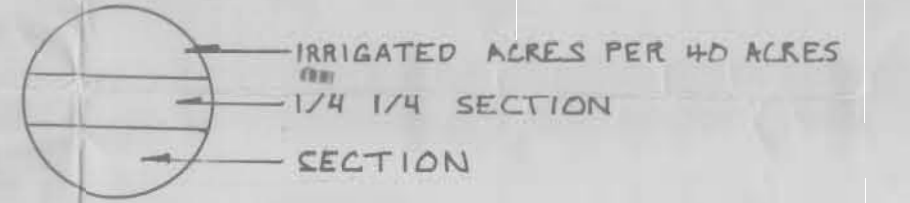

— PHASE I WATER  
 - - - PHASE II WATER  
 - - - PHASE III WATER  
 ○ NO. OF SERVICES

## TYE ENGINEERING, INC.

FRED SCHILLING/ DUANE KATTER  
 22165 BEAR CREEK ROAD  
 BEND, OREGON 97701

Title **APACHE WATER SYSTEM  
 MASTER PLAN**

drafting	EW	no.	date	revisions	sht.
design	WRT	1	8-10-83	NETWORKS ANALYSIS	
scale	1" = 400'		10-2-90	WATER RIGHTS PERMIT INFORMATION	
date	SEPT. 1980		7-25-94	REV. PERMIT, ADD WELL No. 4	
w. o. no.	79911				of

