


T.7S. R.1W., W.M

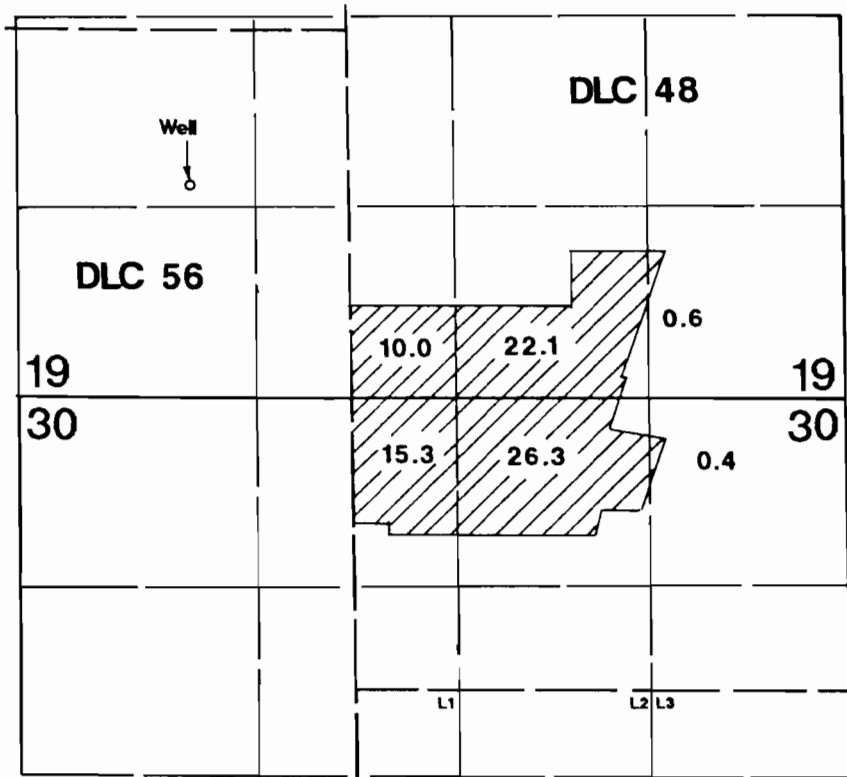

Well is located 1450'N & 1150'E from the SW corner of Section 19.

Final Proof Survey

RECEIVED

Application #: G-14057 Permit #: G-12897

DEC 02 1999

In Name Of

Michael Fordyce

SALEM, OREGON**

Surveyed on November 27, 1999 by JM Schuette

This Map Was Prepared For The Purpose Of Identifying The Location Of A Water Right Only And Is Not Intended To Provide Legal Dimensions Or Location Of Property Ownership Lines.

