


T. 1 S. R. 14 E. W.M.

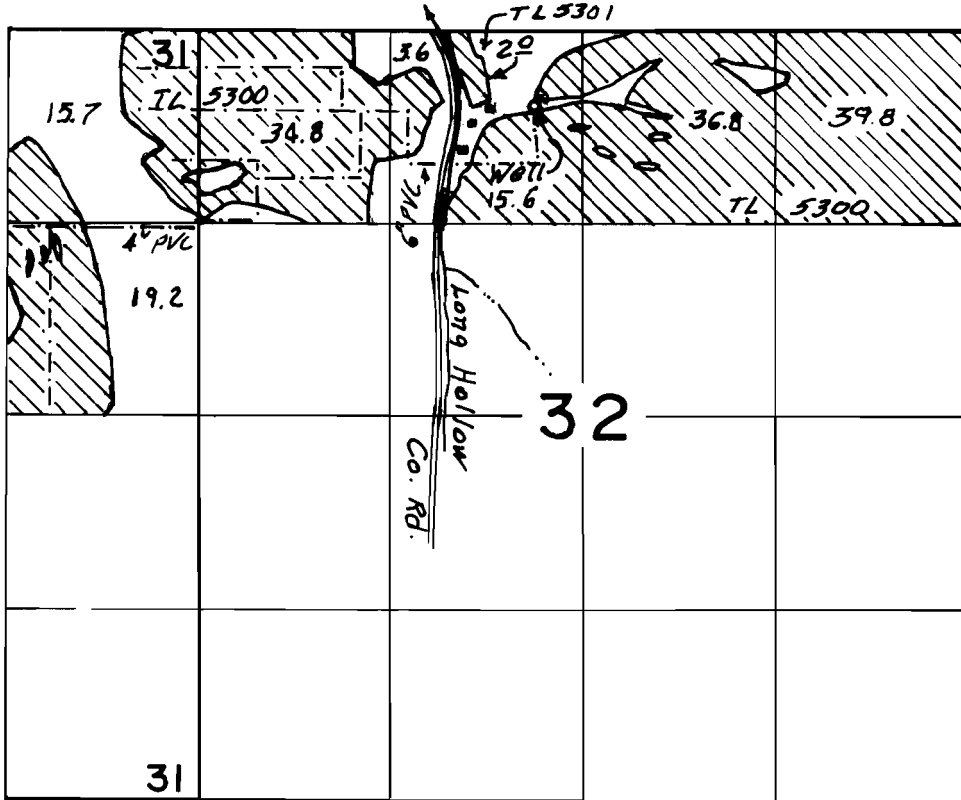


Well loc. 520'S & 320'W from N 1/4 Cor. Sec. 32

FINAL PROOF SURVEY UNDER

Application No. G-14054 Permit No. G-12899

IN NAME OF

TOM MAY

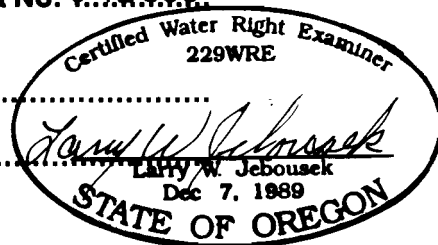

Surveyed SEPT. 15, 2000 by ...

THIS MAP WAS PREPARED FOR THE PURPOSE OF IDENTIFYING THE LOCATION OF A WATER RIGHT ONLY AND IS NOT INTENDED TO PROVIDE LEGAL DIMENSIONS OR LOCATION OF PROPERTY OWNERSHIP LINES.