

FINAL PROOF MAP



FOR Permit G12887
and G12905

T.8S.; R.39E.; W.M.

STATE OF OREGON
WATER RESOURCES DEPT.

OCT 30 1991

RECEIVED

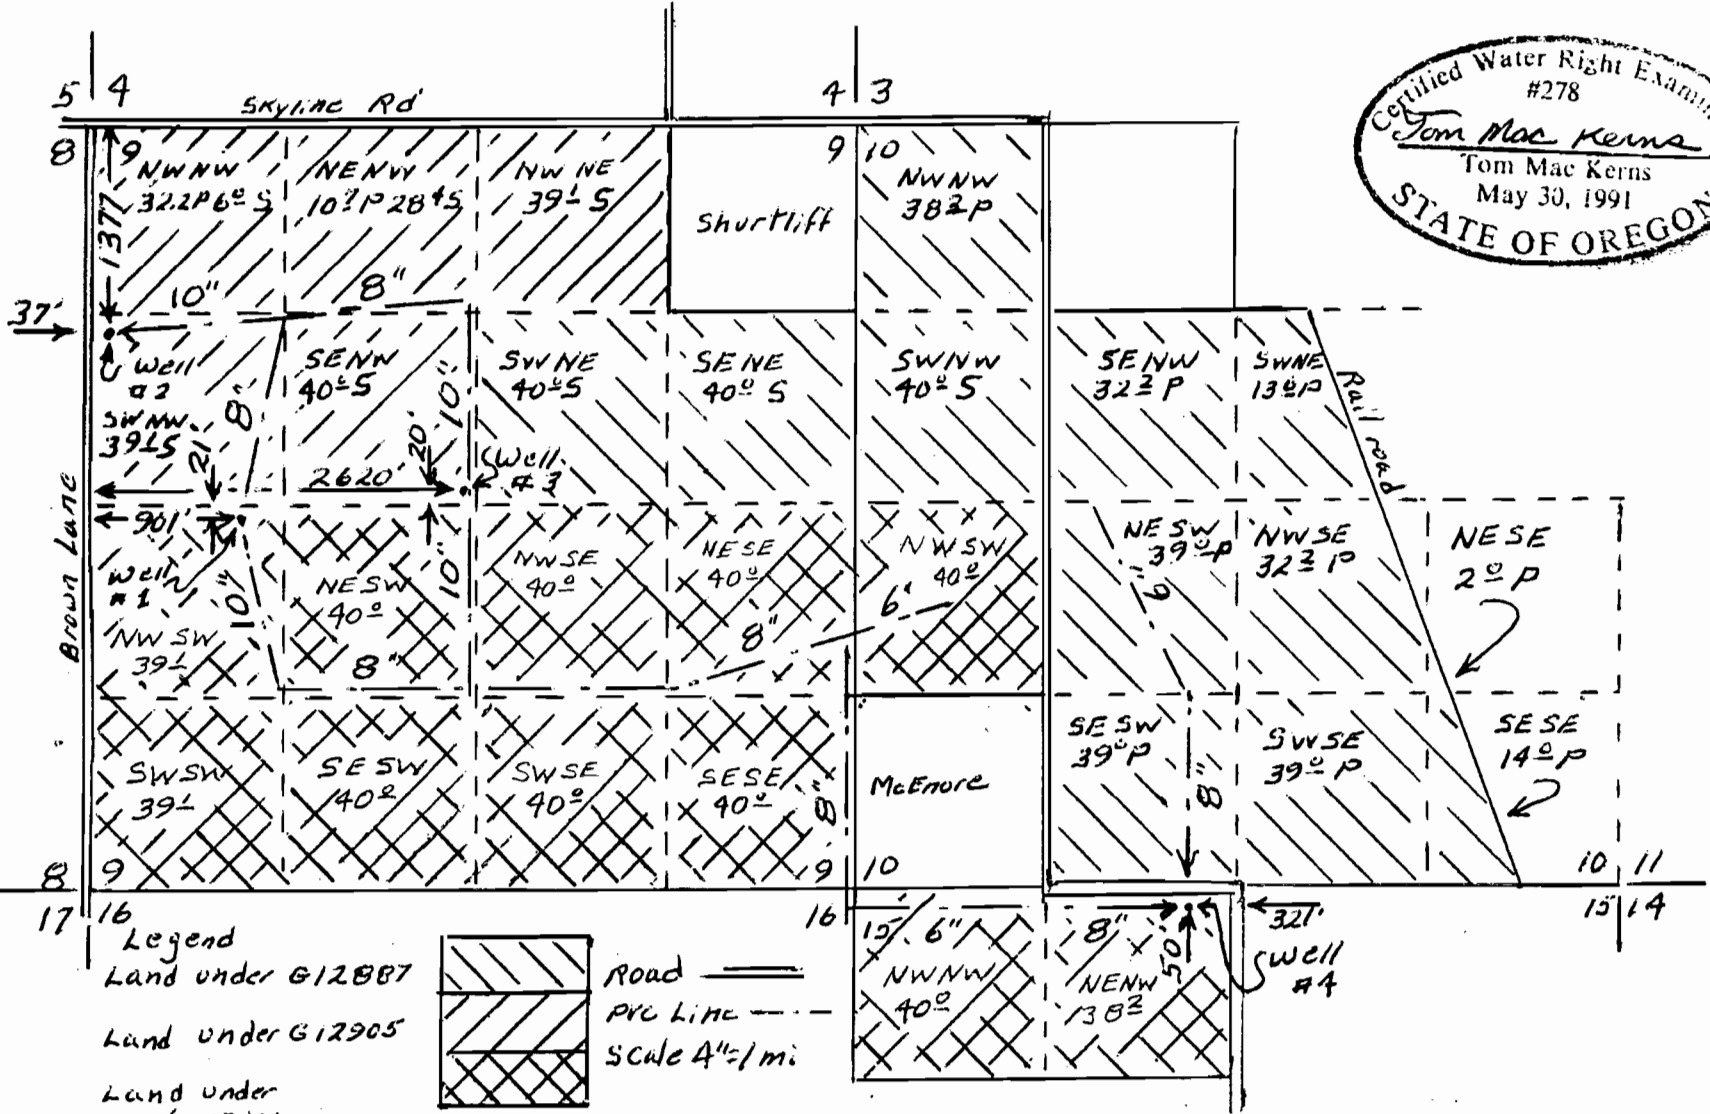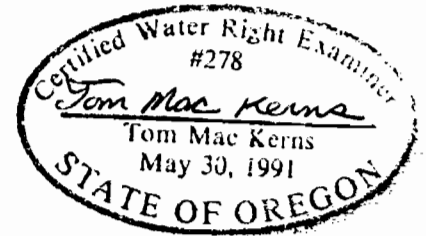

Legend
Land under G12887
Land under G12905
Land under
Air Diversion

Road
Pre Line
Scale 4" = 1 mi

