


T. 4 S. R. 2 W. W.M.

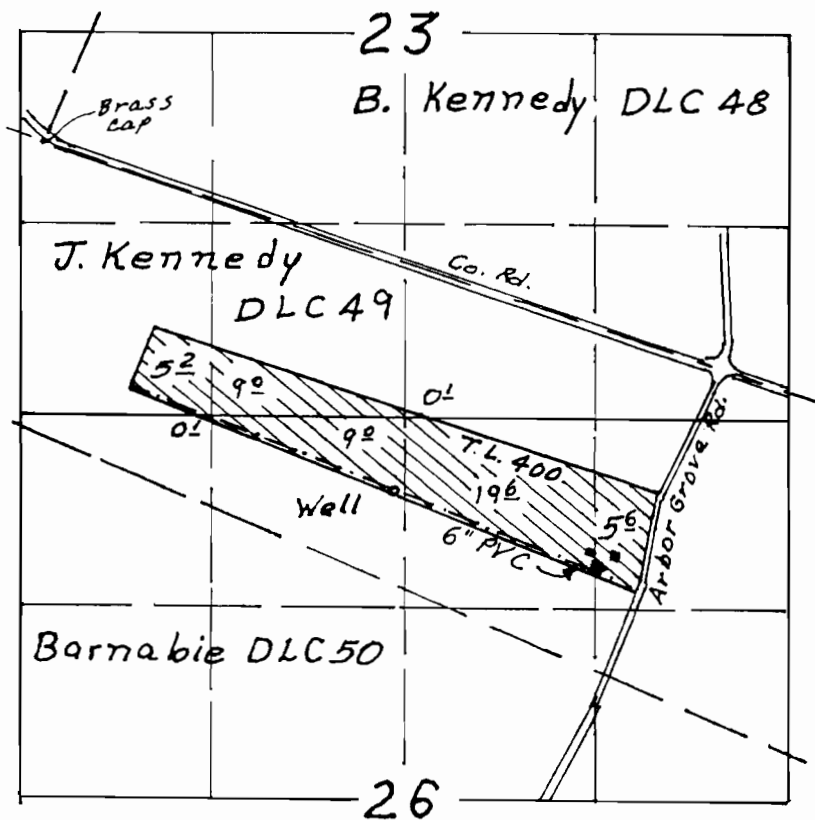

Scale  
4" = 1 Mi.

Well loc. 2400'S & 2400'E from SW cor. DLC 48

# FINAL PROOF SURVEY

## UNDER

Application No. G-14208 Permit No. G-12906  
IN NAME OF

STANLEY E. DANSKEY

Surveyed MARCH 23, 2000

THIS MAP WAS PREPARED FOR THE PURPOSE OF IDENTIFYING THE LOCATION OF A WATER RIGHT ONLY AND IS NOT INTENDED TO PROVIDE LEGAL DIMENSIONS OR LOCATION OF PROPERTY OWNERSHIP LINES.

