



T17S. R47E W.M. 31 | 32
 T18S. R47E. W.M. 6 | 5

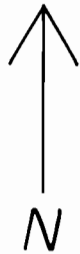


NE/NE

LEGEND


- FOUND SECTION CORNER
- WELL
-  AREA OF SUPPLIMENTAL IRRIGATION
- DIRECTION OF IRRIGATION
- - - DRAIN DITCH
- === FARM ROAD

NOTES

1. THIS MAP IS FOR THEPURPOSE OF LOCATING A WATER RIGHT AND IS NOT INTENDED TO PROVIDE LEGAL DIMENSIONS FOR LOCATION OF PROPERTY BOUNDARIES.
2. DISTANCES SHOWN WERE CALCULATED FROM FIELD SURVEYS
3. SECTION 6 : MALHEUR CO., OR
 TAX LOT 18-47-1400
 PA & ALICE RITTER

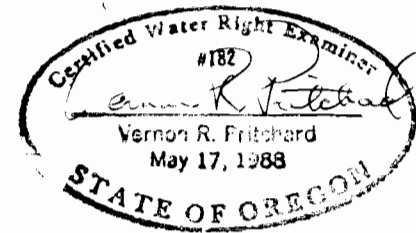

Well is 534 ft North and
 1270 ft West of the E 1/4 Corner
 Section 6

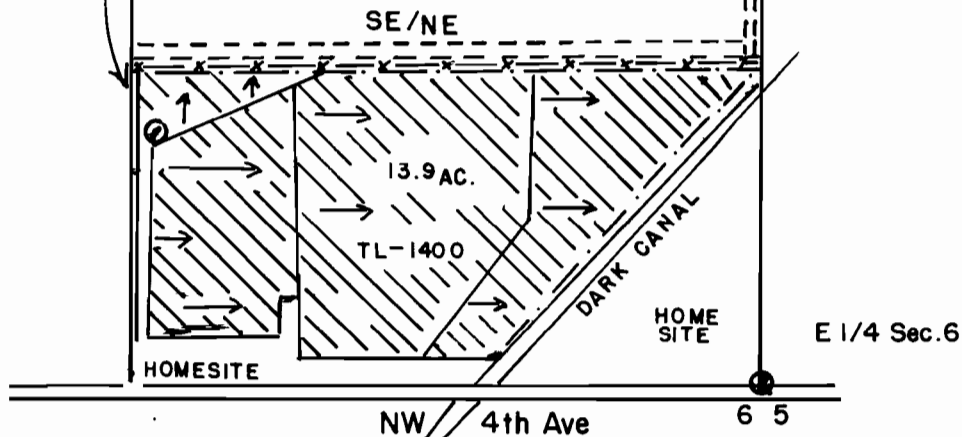

VERN PRITCHARD, CWRE

P.O. BOX 134
 VALE, OR 97918

541-473-3612

FINAL PROOF SURVEY
 G-14172

FOR: ALICE RITTER

Diane H Pritchard
 DRAWN

SCALE 1" = 400'

Vernon R. Pritchard
 APPROVED

DWG NO. 012

DATE SEPT. 24, 2000

SHEET 1 OF 1