


T. 11S., R. 43E., W.M.

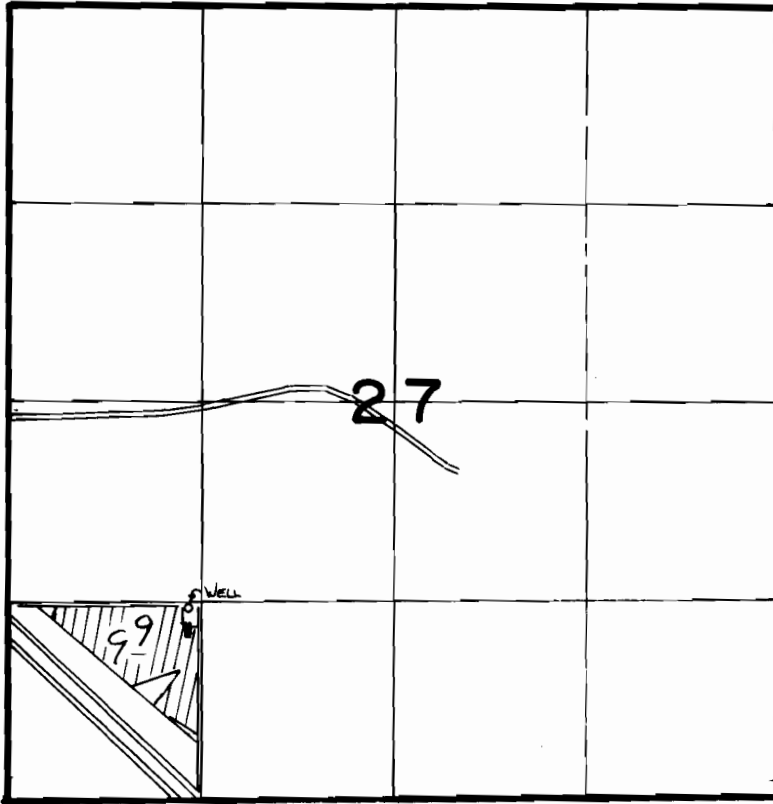

SCALE 1" = 1320'

Well Loc: 40'S & 70'W. From NE Cor.
SW 1/4 SW 1/4 Sec. 27

The purpose of this map is for identifying the location of the water right only and is not intended to provide legal dimensions of property ownership lines.

FINAL PROOF SURVEY

UNDER

APPL. G-14129

PER. G-12914

IN NAME OF

William J. & Vivian M. Zikmund

Surveyed August 10, 1997.

