

T4S, R1W W.M.

T4S, R1E W.M.

IRRIGATION MANIFOLD

416'

RECEIVED

NOV 17 1997

WATER RESOURCES DEPT.
SALEM, OREGON

8.35 AC.

1030'

S. LONE ELDER RD.
Co. Rd. No. 59

GEORGE IRVIN D.L.C.


304' 179'

607' 1355'

12 7
13 18

1434'

NORTH

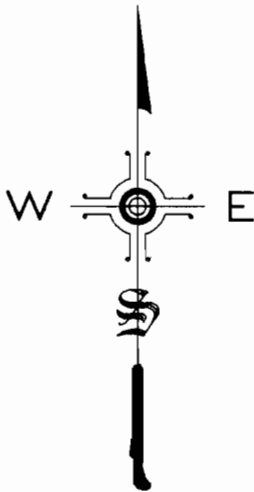

SCALE 1"=400'


Russell L. ...
REVIEWED 12-31-98

MERIDIAN Rd.

FINAL PROOF SURVEY FOR
CLAIM OF BENEFICIAL USE
FOR

WEYERHAUSER CO.

LEGEND:

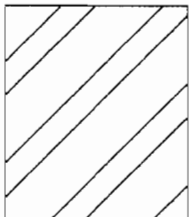

REPRESENTS
AREA OF
BENEFICIAL USE

Application No. G-14159 Permit No. G-12935

WILLAMETTE LAND SERVICES

19478 STARVIEW LANE
OREGON CITY, OR. 97045
(503) 631-8184

DATE 11/03/97

PAGE 1 OF 1