

WELL IS 650' NORTH AND 1' WEST OF THE SW CORNER OF SEC. 30, T 2S, R 45E, BUT IS IN THE SW 1/4, SW 1/4 SEC 30 DUE TO THE SLIGHT WESTERLY BEARING OF THE SECTION LINE.

THIS FINAL PROOF MAP IS FOR A 100 FT DEEP WELL TO BE USED TO FILL THE FIRE POND AND SUPPLY THE BOILER, KILN, AND MILL BUILDINGS FOR THE JOSEPH TIMBER SAWMILL.


THIS MAP IS PREPARED FOR WATER RIGHT PURPOSES ONLY AND SHOULD NOT BE USED FOR PROPERTY LOCATION PURPOSES.

MAP IS BASED ON WALLOWA COUNTY ASSESSOR MAPS AND FIELD SURVEY.

RECEIVED

SEP 25 2000

WATER RESOURCES DEPT  
SALEM, OREGON

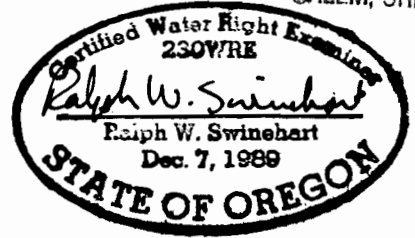

PERMIT G-12943

IN SW 1/4, SW 1/4 SEC 30  
T 2S, R 45E, W.M  
WALLOWA COUNTY

GROUND WATER WATER  
RIGHT FINAL PROOF MAP  
FOR:  
JOSEPH TIMBER COMPANY  
JOSEPH, OREGON