RECEIVED
JUN 1 1992
DEPT. of REVENUE STATE OF OREGON
ASSESSMENT & APPRAISAL DIV.

SCALE 1:9600

400 0 400 800 FEET

0 20 40 KILOMETER

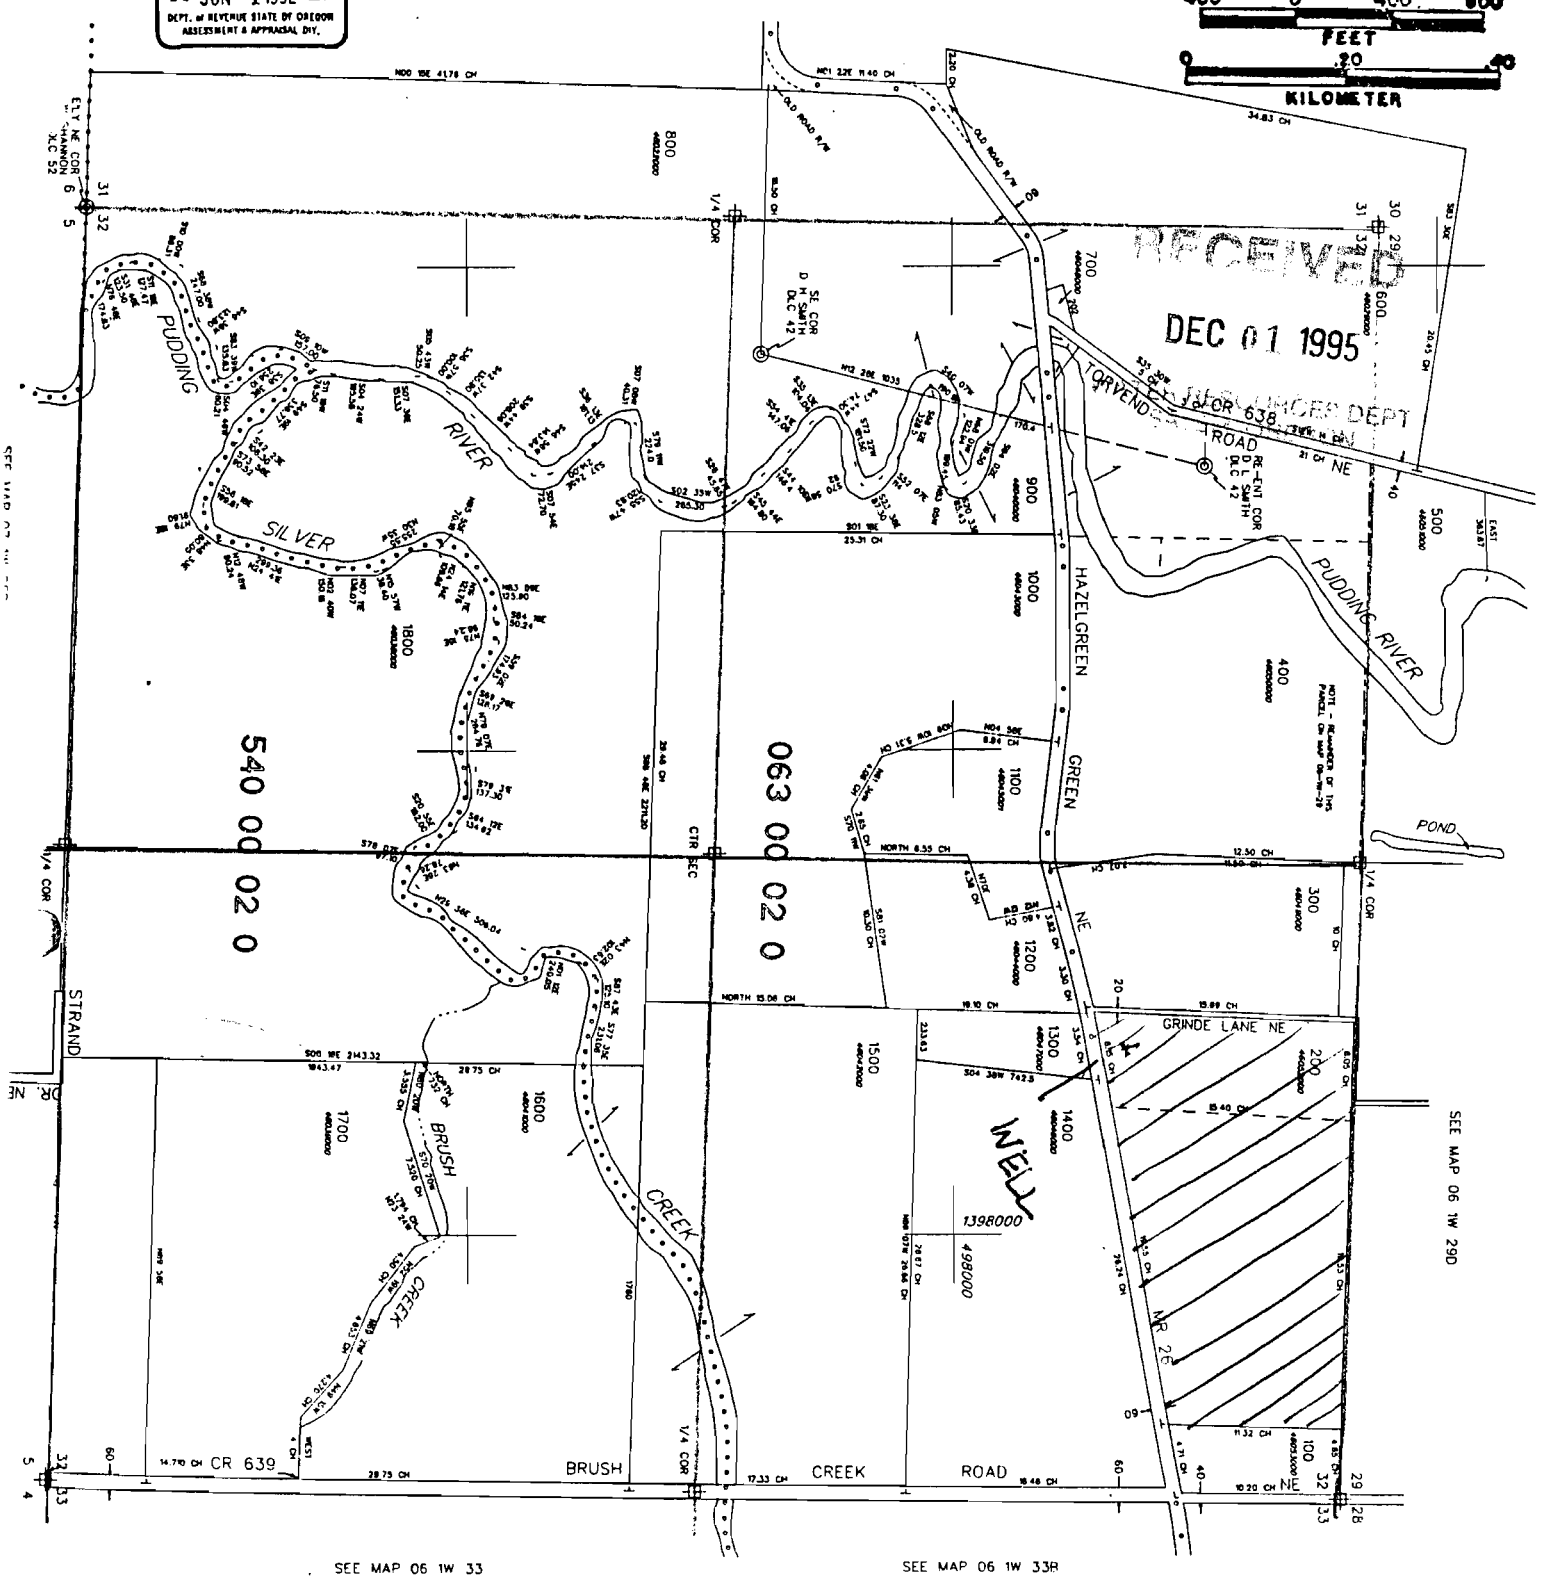

RECEIVED
DEC 01 1995
ASSESSORS DEPT

1"=400'
27-FEB-91

6 1W 32

Application No. 14842
Permit No.