
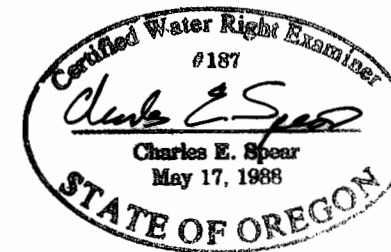


FINAL PROOF MAP
 For
JAMES & ANNE BURKEY
 Portions of Sections 31 & 32,
 Township 4 South, Range 2 East, W.M.,
 Clackamas County, Oregon

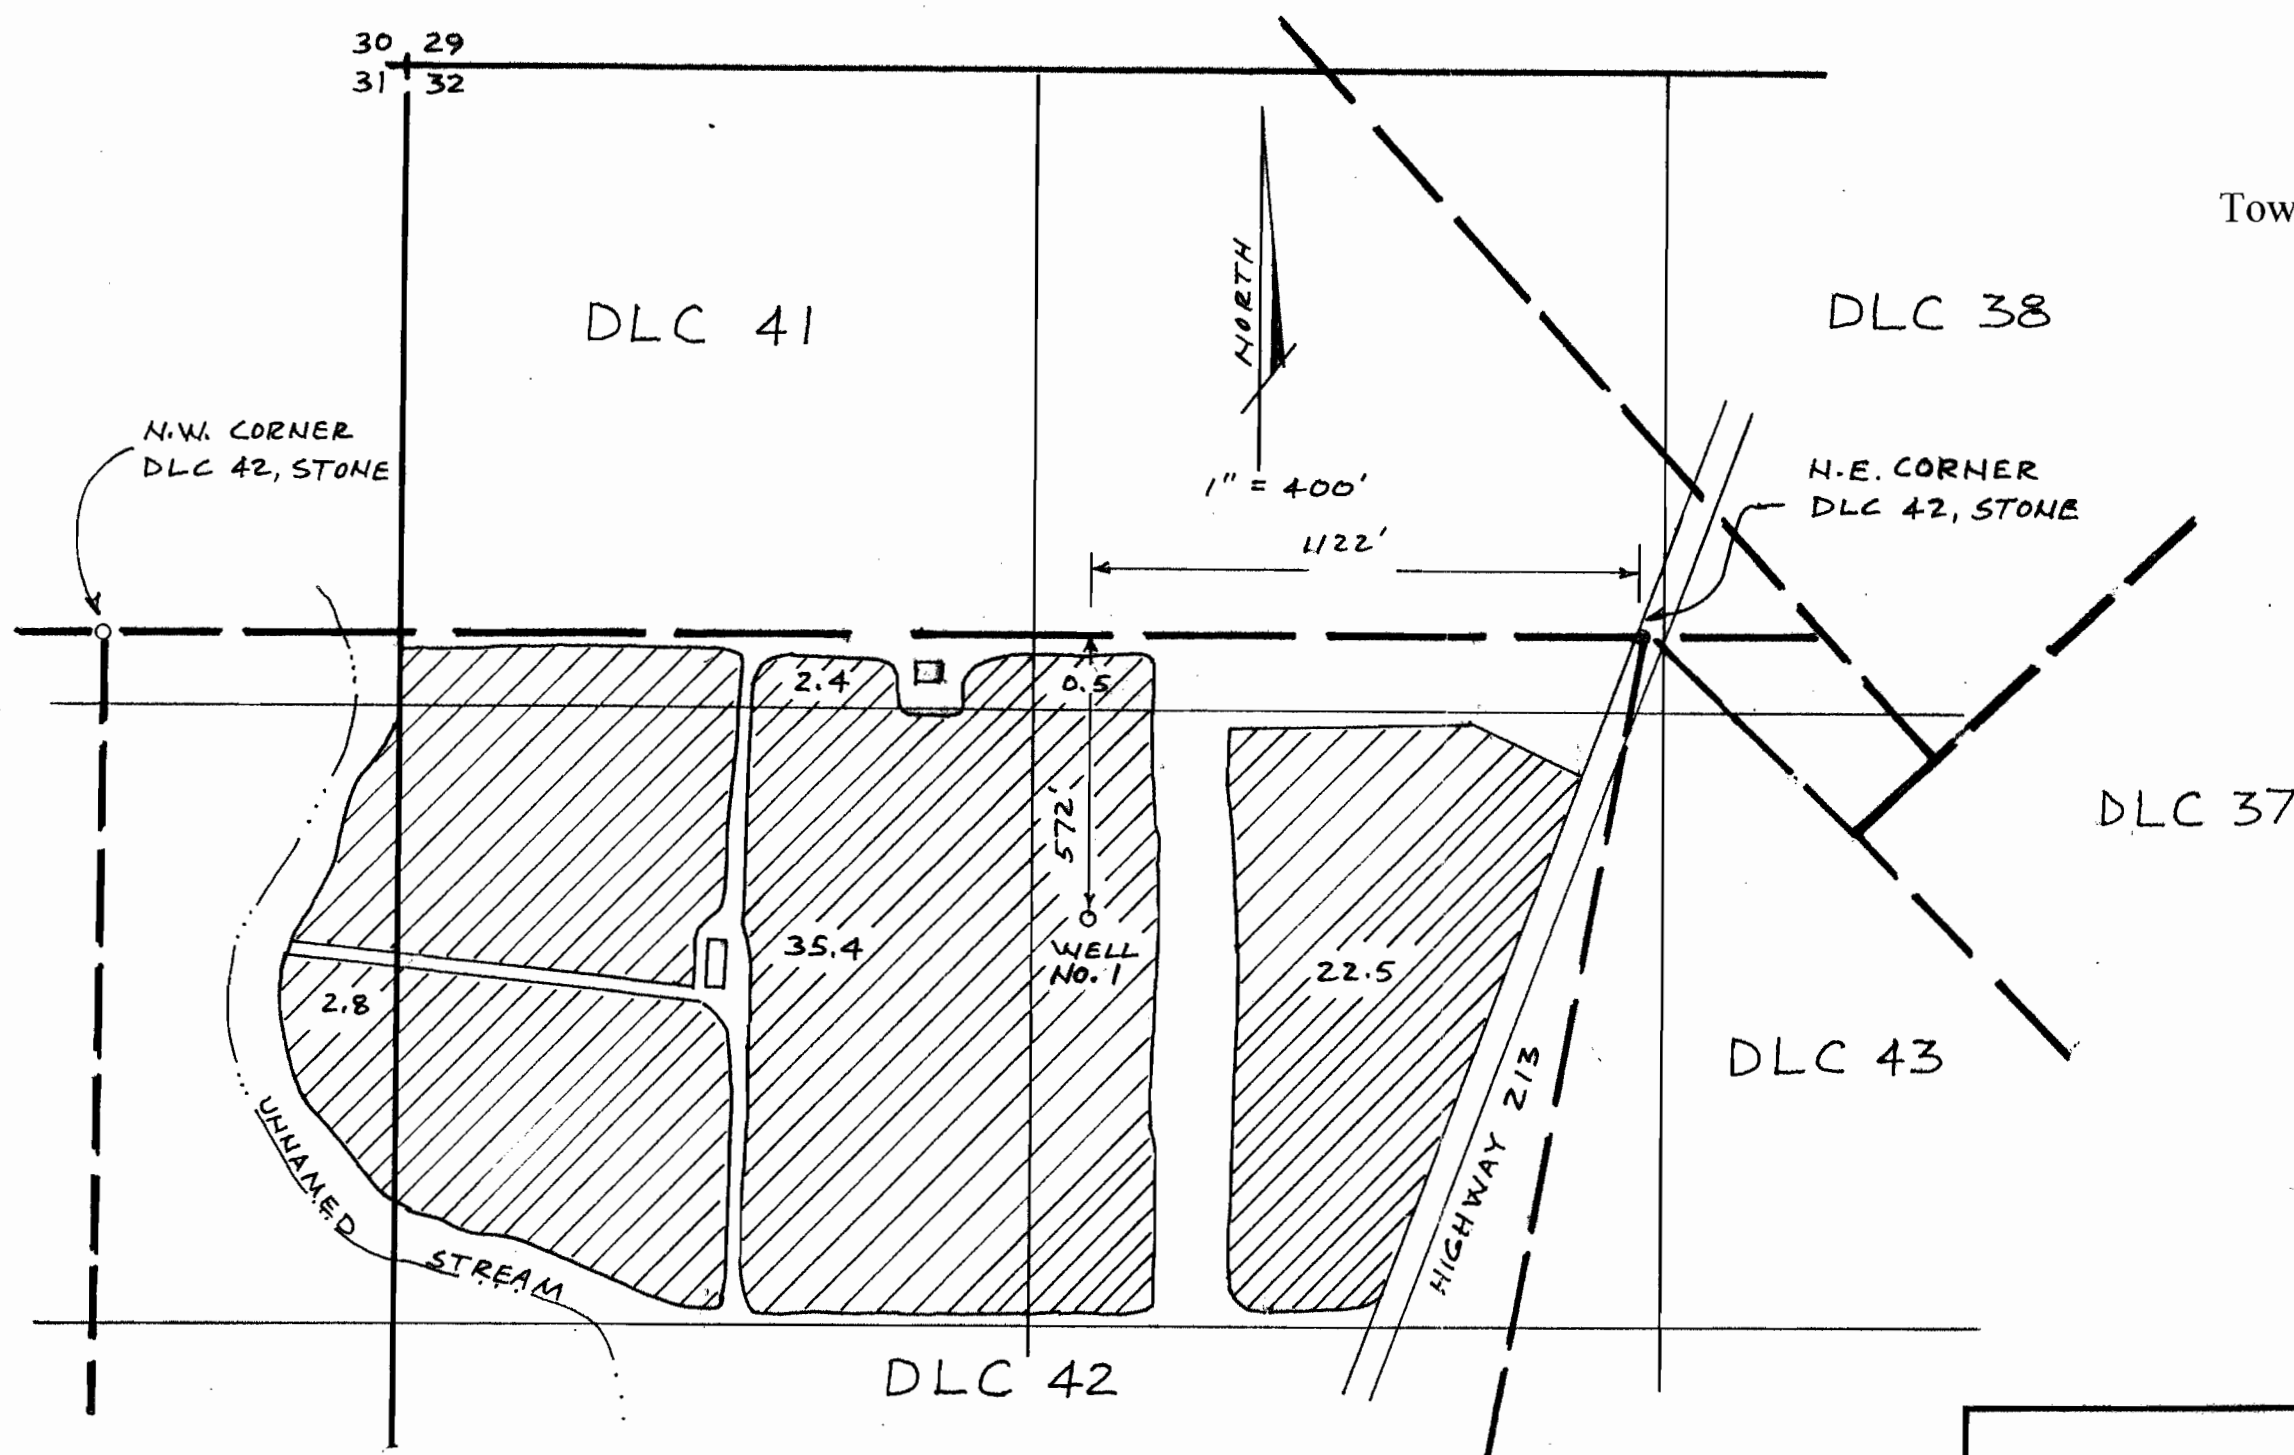

PREPARED BY
 SPEAR SURVEYING SERVICES
 P.O. BOX 1834, HILLSBORO, OR 97123
 PHONE: (503) 648-2879

RECEIVED
 APR 15 2005
 WATER RESOURCES DEPT
 SALEM, OREGON

Application No. G-13867 Permit No. G-12962		
SCALE: 1" = 400'	APPROVED BY:	DRAWN BY: CES
DATE: 1/3/05		REVISED:
COBU MAP # 0164		DRAWING NUMBER