
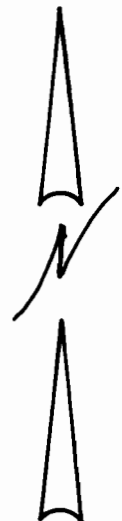


T.6 S. R.2 W. W.M.

RECEIVED

MAY 10 1984

REGISTERED AND DUPLICATED
54 N.W. OREGON

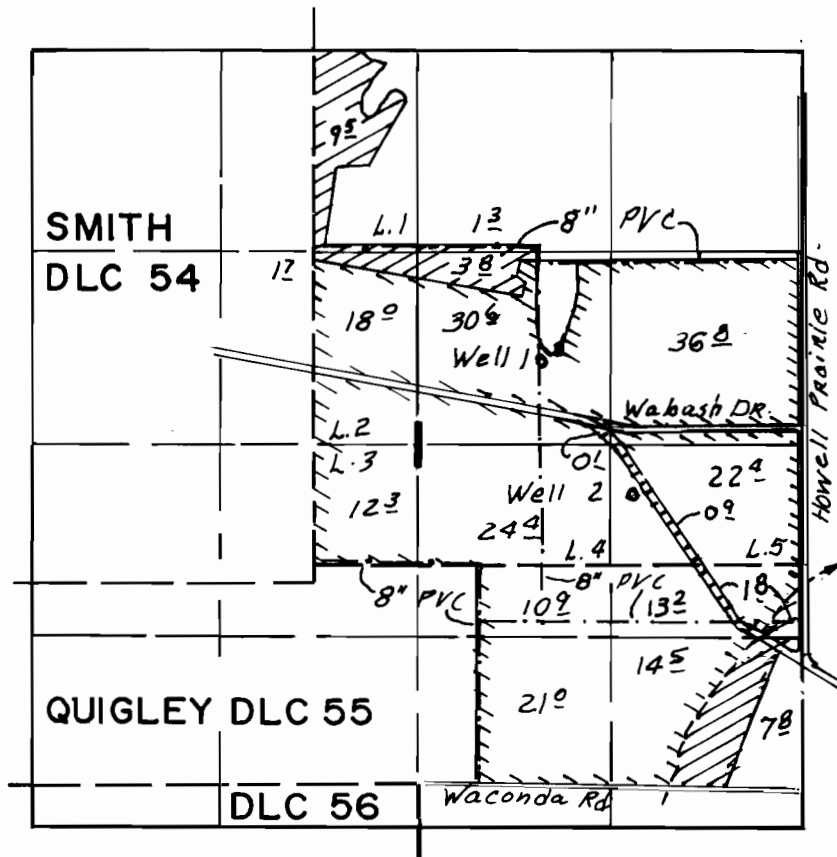

Scale
4" = 1 Mi.

Well 1 loc. 1370' N & 1510' E from SW Cor lot 3
Well 2 loc. 490' N & 2180' E " " " " "

Primary
Suppl.

FINAL PROOF SURVEY UNDER

TRANSFER NO. T-6903


Application No. G-14252 Permit No. G-12962

IN NAME OF

BOB FESSLER

THIS MAP WAS PREPARED FOR THE
PURPOSE OF IDENTIFYING THE LOCA-
TION OF A WATER RIGHT ONLY AND IS
NOT INTENDED TO PROVIDE LEGAL
DIMENSIONS OR LOCATION OF PROPER-
TY OWNERSHIP LINES.

Surveyed April 26 1999, by

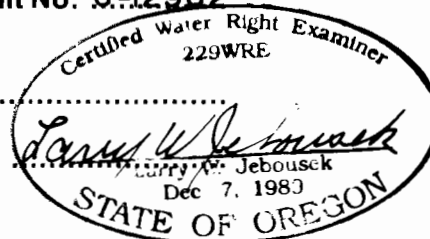

WAC -92 6-18