


TOWNSHIP 39 SOUTH, RANGE 36 EAST, W.M.

RECEIVED

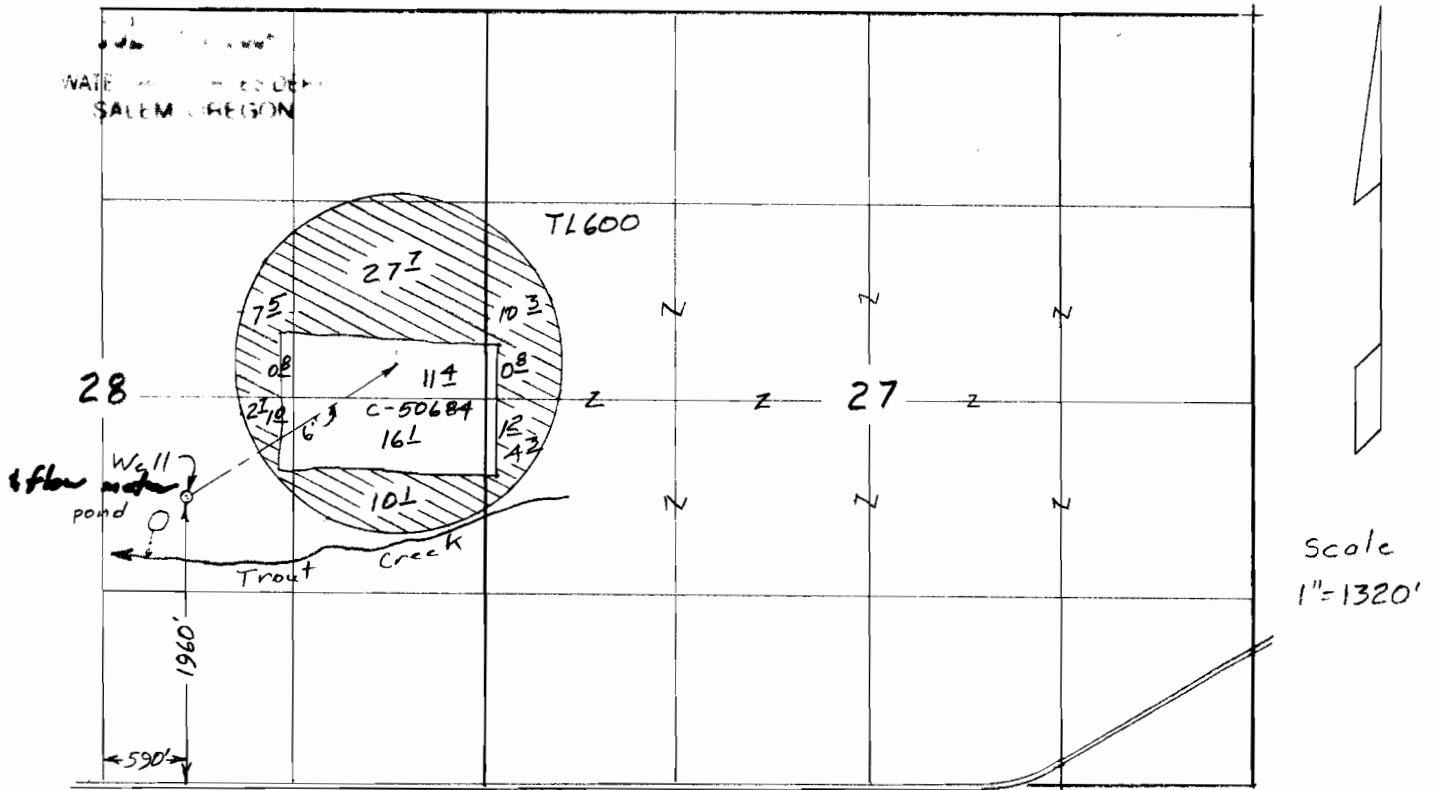


Surveyed June 28 & 29, 2002 & May 27, 2003

Claim of Beneficial Use Map
for
WRENCH RANCH, LLC

C-50684 31²/₃ acres
G-12970 62²/₃ acres

App G-13849
Per G-12970

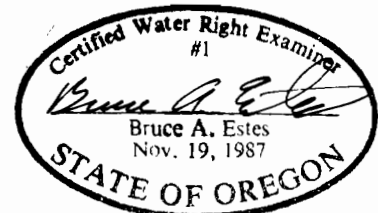

Renewal Dec 31, 2003

This map is for the purpose of locating a water right only and has no intent to provide legal dimensions or the location of property lines.

ESTES SURVEYS, LLC
PO Box 17519 60382 Arnold Rd
Salem, OR 97305-7519 Bend, OR 97702
(503) 585-7593 (541) 382-7391

Amended 9-Jan-06