


T.6S. R.39E. W.M.

*Some wells  
1967 - G-12*

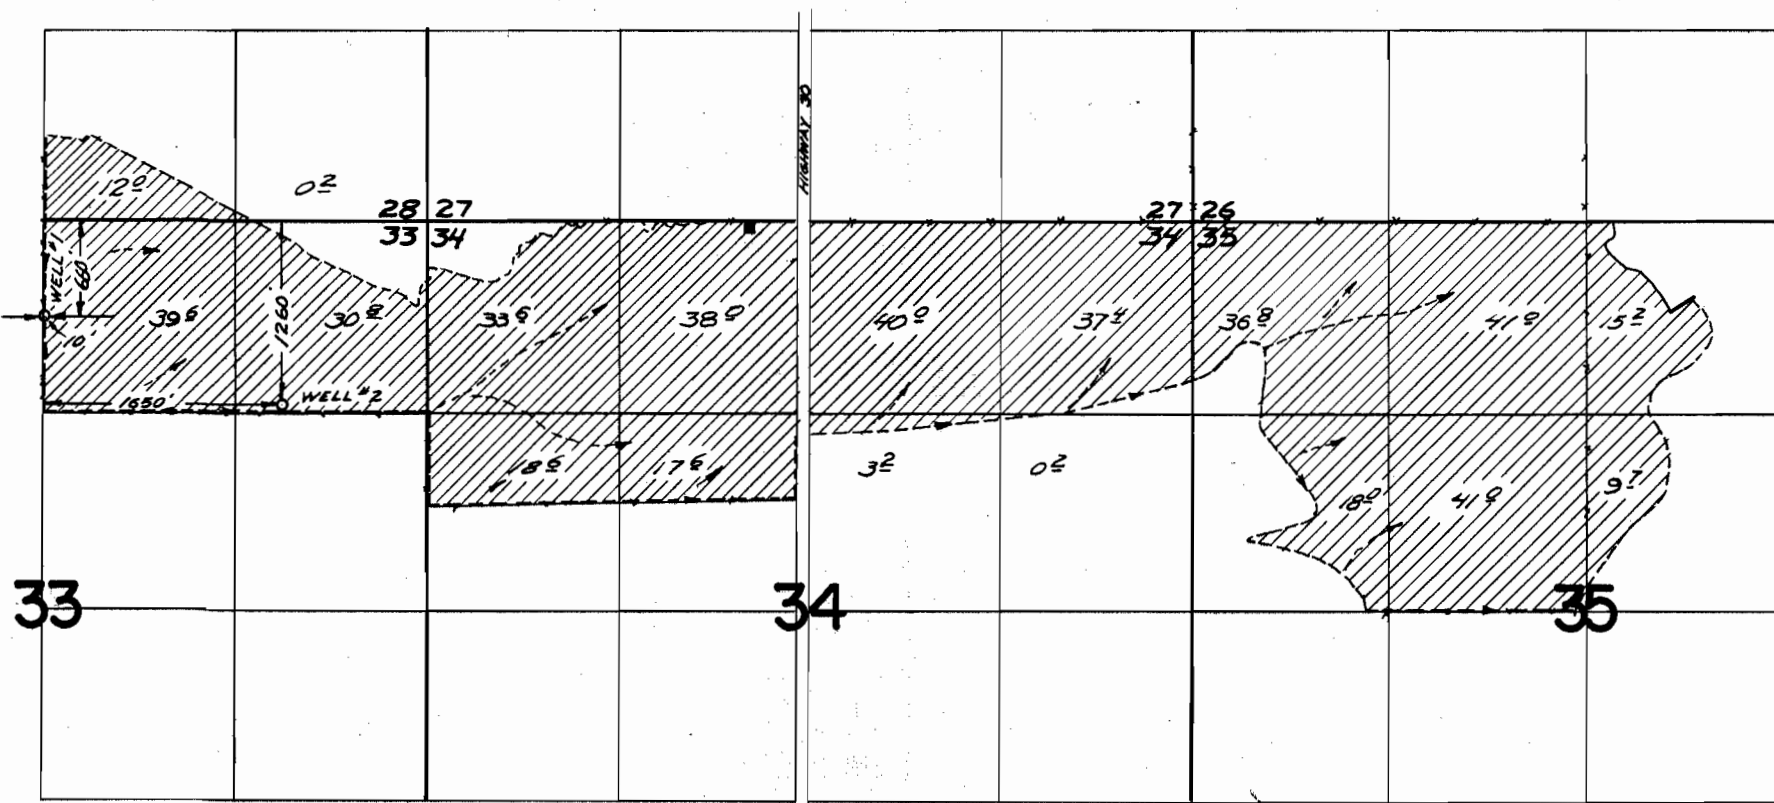

**FINAL PROOF SURVEY**

UNDER

Application No. G 2861      Permit No. G 2662

*Cert No. 35203*

IN NAME OF

**R. D. RASMUSSEN**

Surveyed October 31, 1967 by V. R. Garner