


FINAL PROOF SURVEY MAP IN THE NAME OF BLANCO BOGS

APPLICATION G-12660

PERMIT G-12993

SECTION 32, TOWNSHIP 31 SOUTH, RANGE 15 WEST, W.M.
AND
SECTION 5, TOWNSHIP 32 SOUTH, RANGE 15 WEST, W.M.

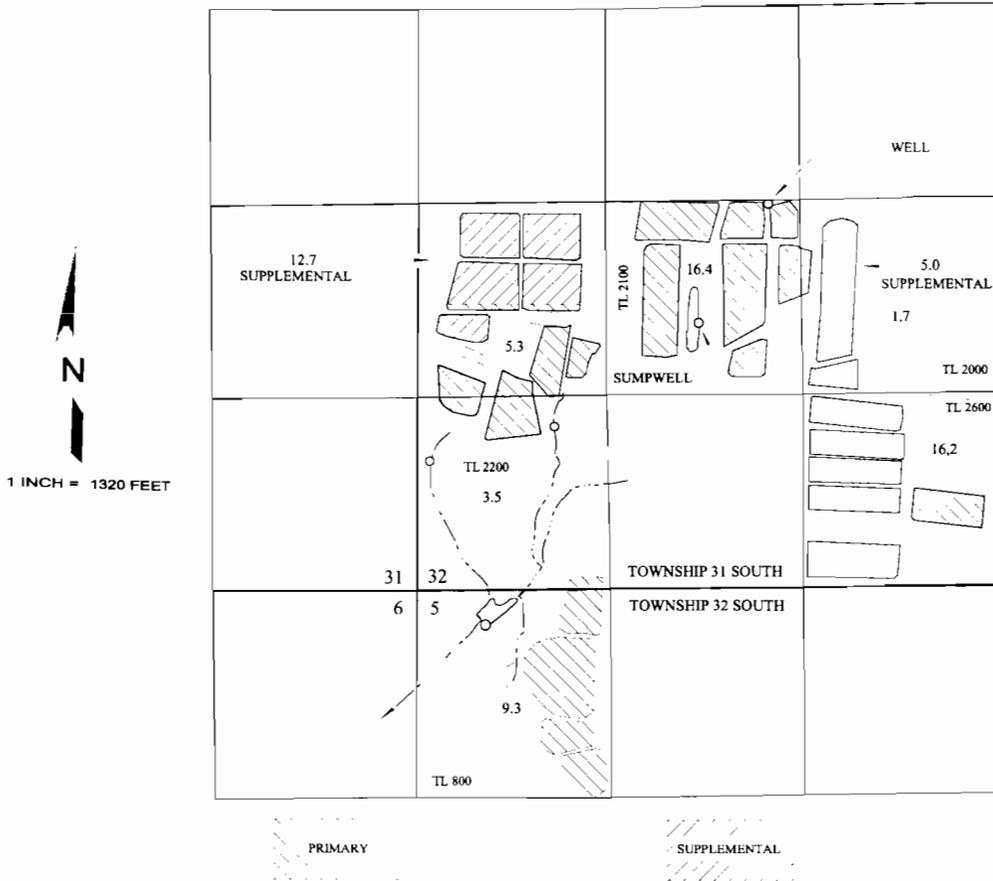

THE WELL IS LOCATED 2700 FEET NORTH AND 2430 FEET EAST ; AND THE SUMPWELL IS LOCATED 1860 FEET NORTH AND 1960 FEET EAST; BOTH FROM THE SOUTHWEST CORNER OF SECTION 32, BEING WITHIN THE NE¹/₄SW¹/₄ OF SECTION 32, TOWNSHIP 31 SOUTH, RANGE 15 WEST, W.M.; CURRY COUNTY.

THE PURPOSE OF THIS MAP IS TO IDENTIFY THE LOCATION OF THE WATER RIGHT. IT IS NOT INTENDED TO PROVIDE INFORMATION RELATIVE TO THE LOCATION OF PROPERTY OWNERSHIP BOUNDARY LINES.

RECEIVED

SEP 25 2000

WATER RESOURCES DEPT
SALEM, OREGON

