

PARCEL 1
12373

3600
3.914

C.S. 20477

PARTITION PLAT NO. 1992-40

G-13998

G-13997

1" = 200'
200'
See Map 14 & 14D

EDMUNDS INDUSTRIAL TRACTS

HALSE

E 1/4 COR

MAP 1 OF 2

RECEIVED

SEP - 9 1996

WATER RESOURCES DEPT.
SALEM, OREGON

APPLICATION: 613998


PERMIT: G12998

MAP 2 of 2

RECEIVED

SEP - 9 1996

WATER RESOURCES DEPT.
SALEM, OREGON

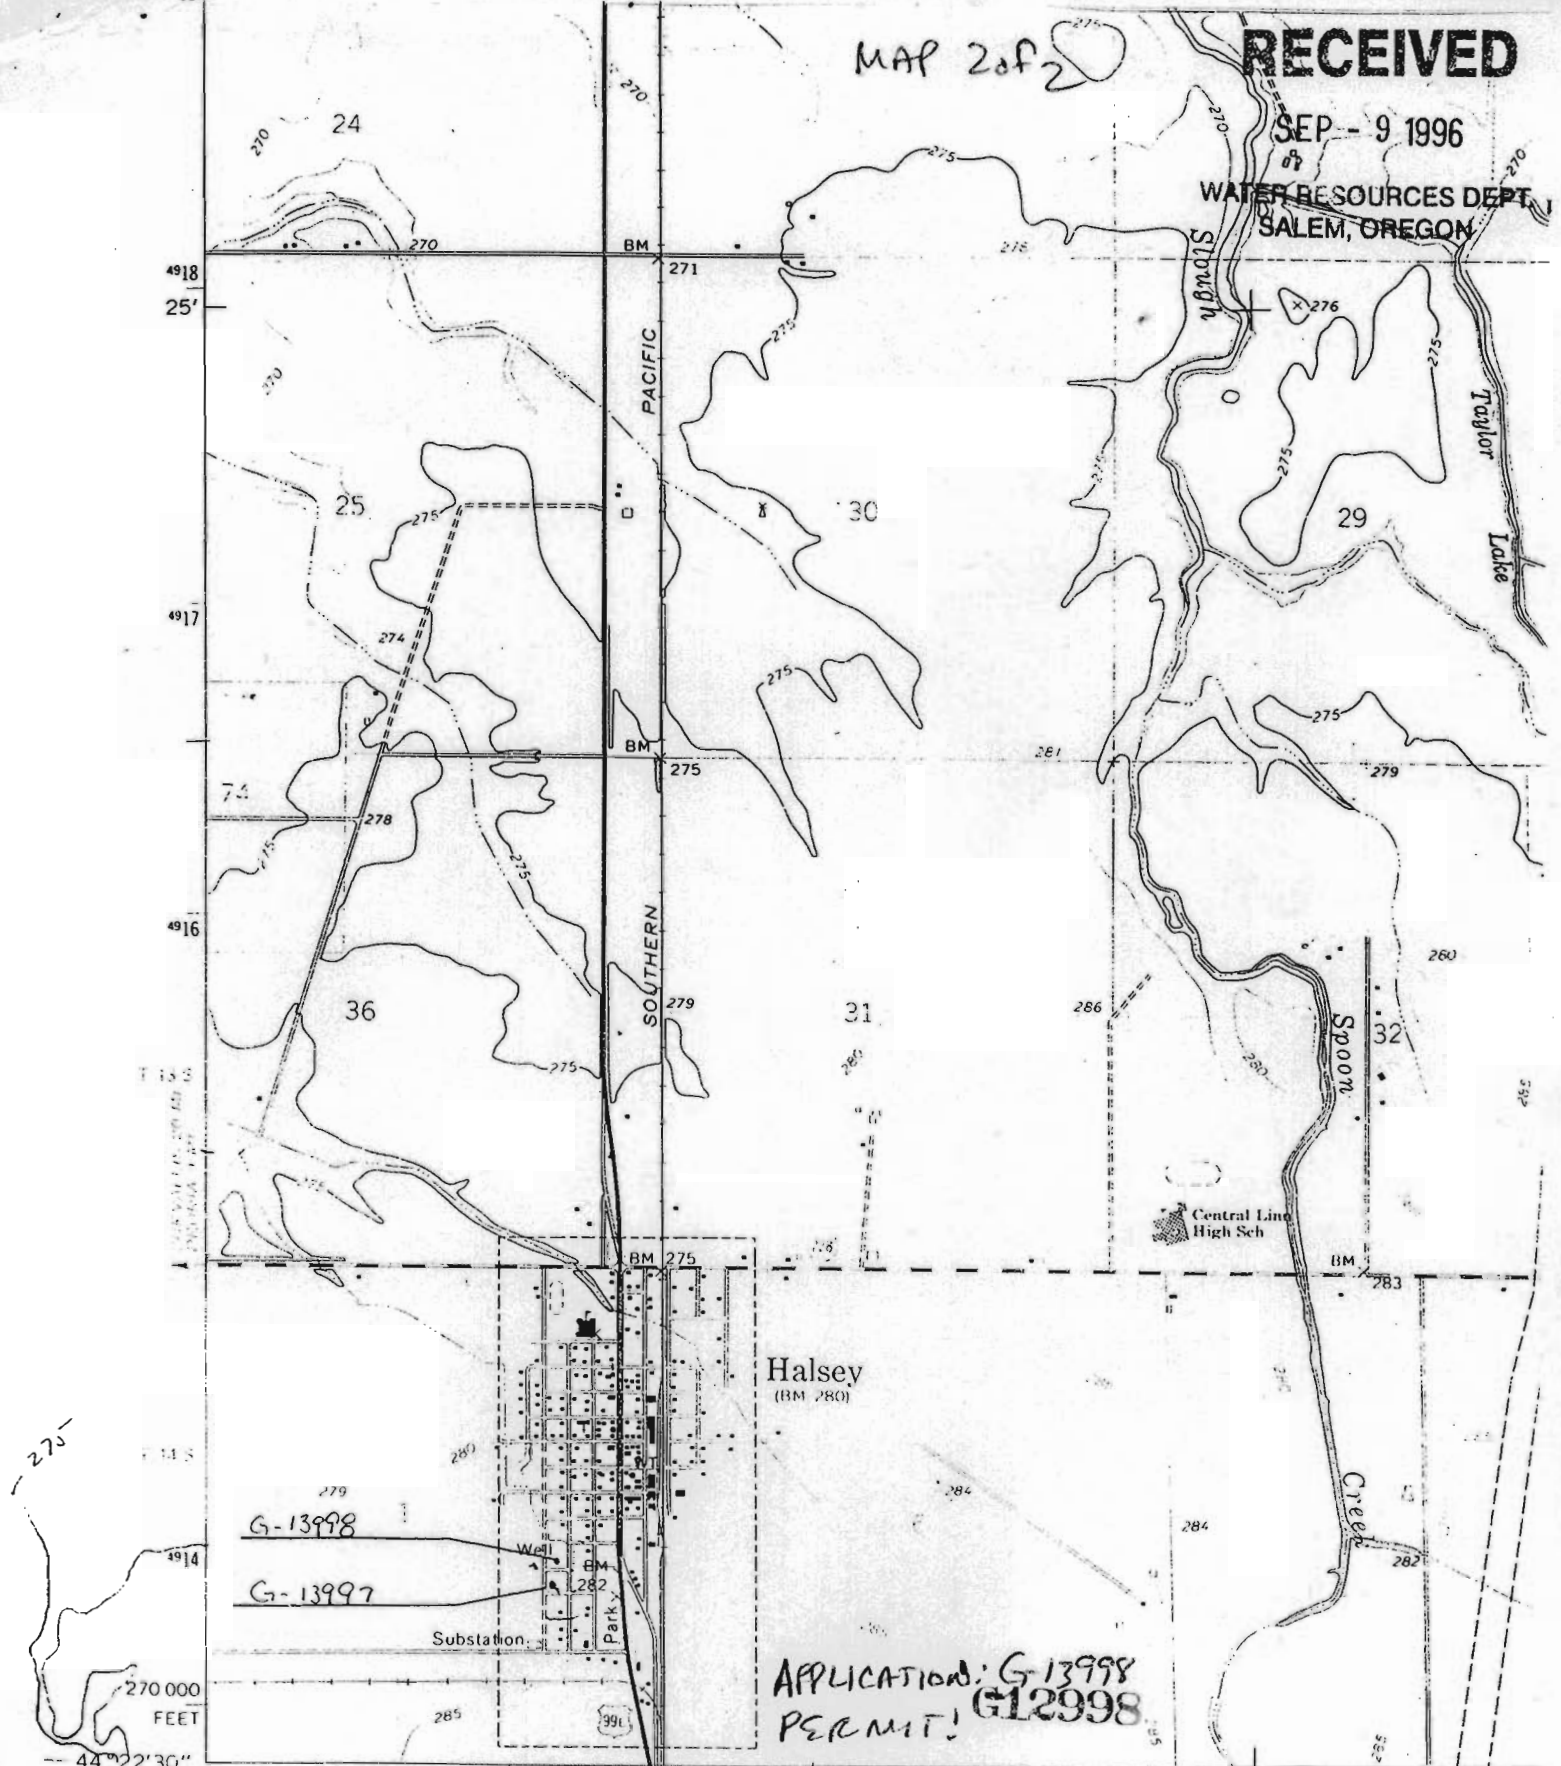

(HARRISBURG)
1372 1 SW

Mapped, edited, and published by the Geological Survey

Control by USGS, USC&GS, and State of Oregon

Topography by photogrammetric methods from aerial photographs taken 1967. Field checked 1969

Polyconic projection. 1927 North American datum
10,000-foot grid based on Oregon coordinate system, north zone

1000 meter Universal Transverse Mercator grid ticks,

