

CLAIM OF BENEFICIAL USE

APPLICATION No. G-14098

PERMIT No. G-12999



TAX LOT No. 8 40 500 - BAKER COUNTY



SCALE: 1" = 1320'

FOR:

MICHAEL H. & ANN TRINDLE
20859 SUNSET LANE
BAKER CITY, OR 97814

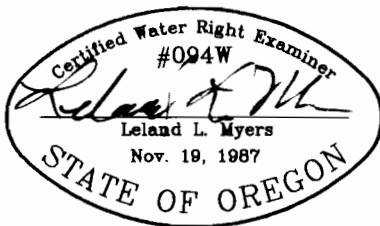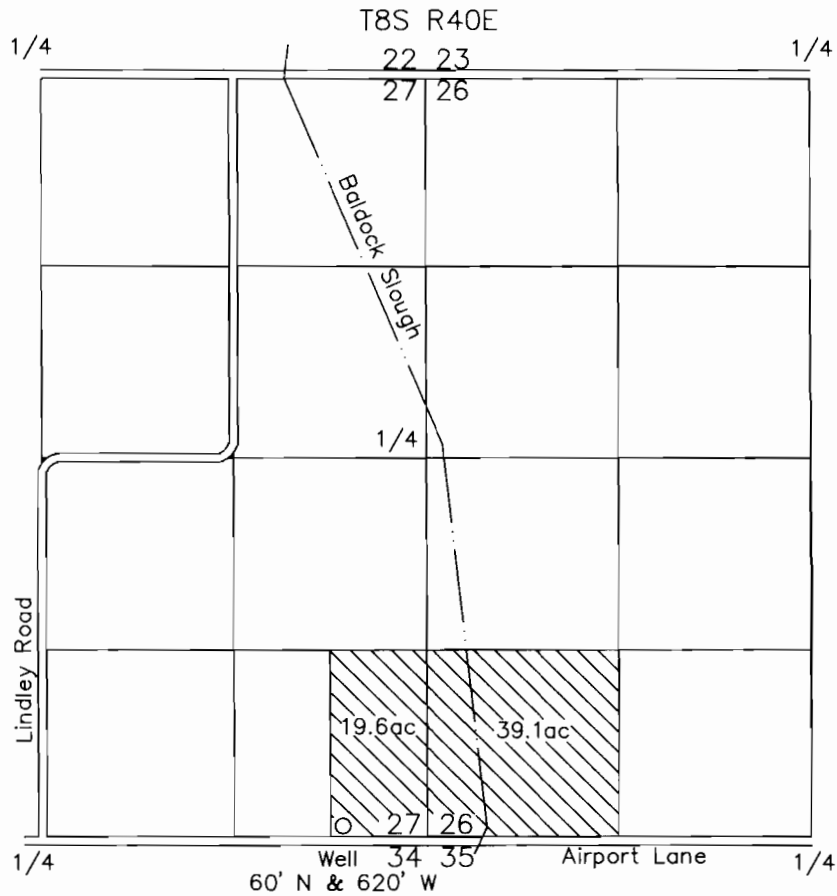

This map is for the purpose of identifying the location of the water right only and has no intent to provide dimensions or location of property ownership lines.

RECEIVED

NOV 19 1987

STATE OF OREGON