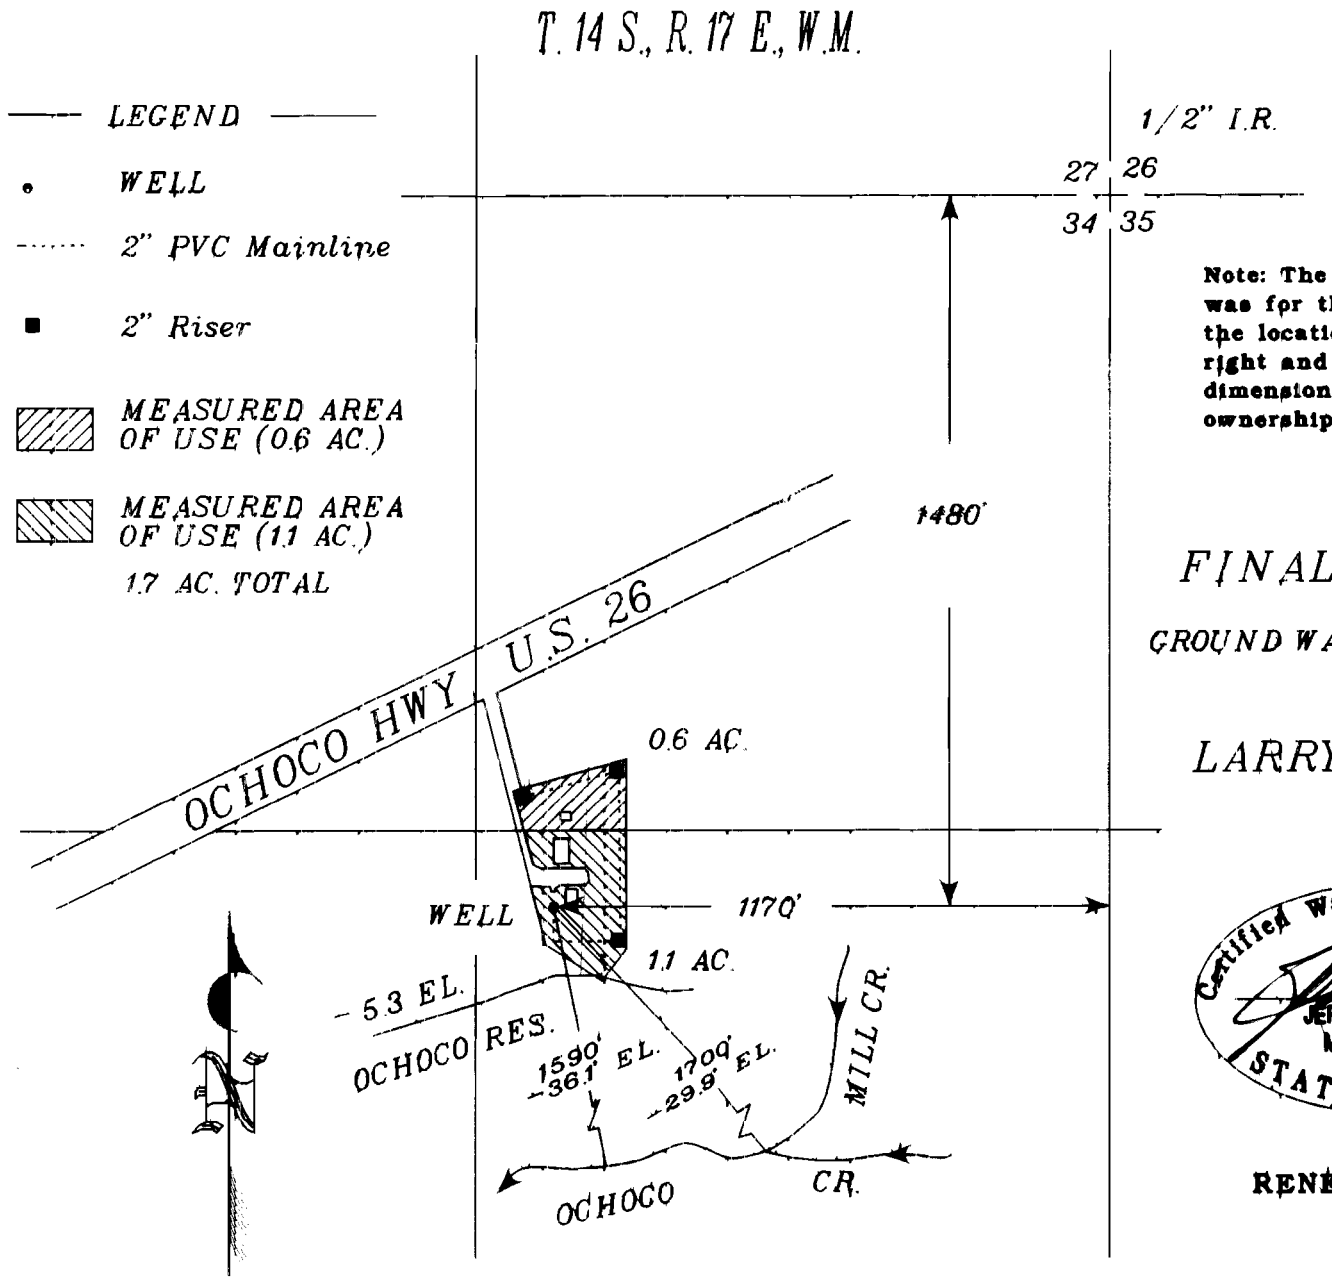

Note: The preparation of this map was for the purpose of identifying the location of the proposed water right and has no intent to provide dimensions or locations of property ownership lines.

FINAL PROOF MAP

GROUND WATER APPROPRIATION

FOR

LARRY FRIESEN

BY

Certified Water Right Examiner
284
JERROLD L. PAGE
May 30, 1991
STATE OF OREGON

4-4-99

RENEW 12-31-00