


Exhibit "C"

Final Proof Map For Permit G-13011



Scale 1" = 1320'

- Legend:**
- Co. Road
 - Main line and Irrigated under G-13011
 - Well

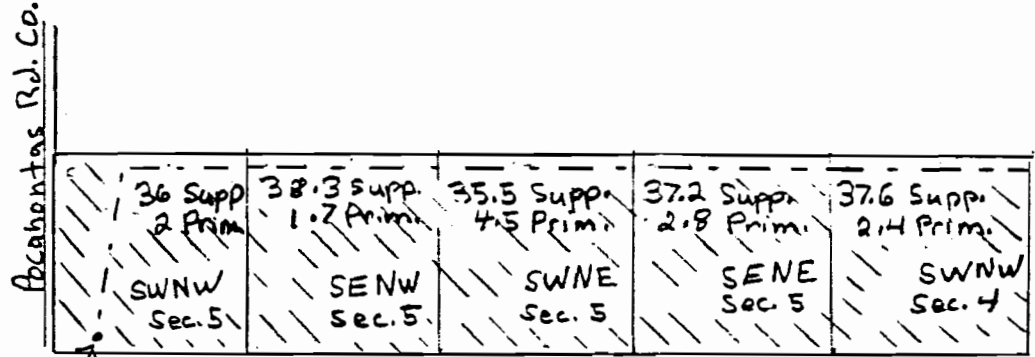

Well Location/Point of Diversion
 320' E of the South west
 corner and 12' N of the
 south line of the SW $\frac{1}{4}$ NW $\frac{1}{4}$
 of section 5
 T. 8 S., R. 39 E., W. M.

All land is being irrigated
 with wheelines or handlines

RECEIVED

MAY 17 2001

WATER RESOURCES DEPT.
SALEM, OREGON



I certify the information provided in this final proof is an accurate representation of the permitted water use and is true and correct to the best of my knowledge. This map is to be used for the purpose of identifying the location of water rights and is not intended to provide legal dimensions or location of property ownership lines.