



T.8S., R.4W., W.M.

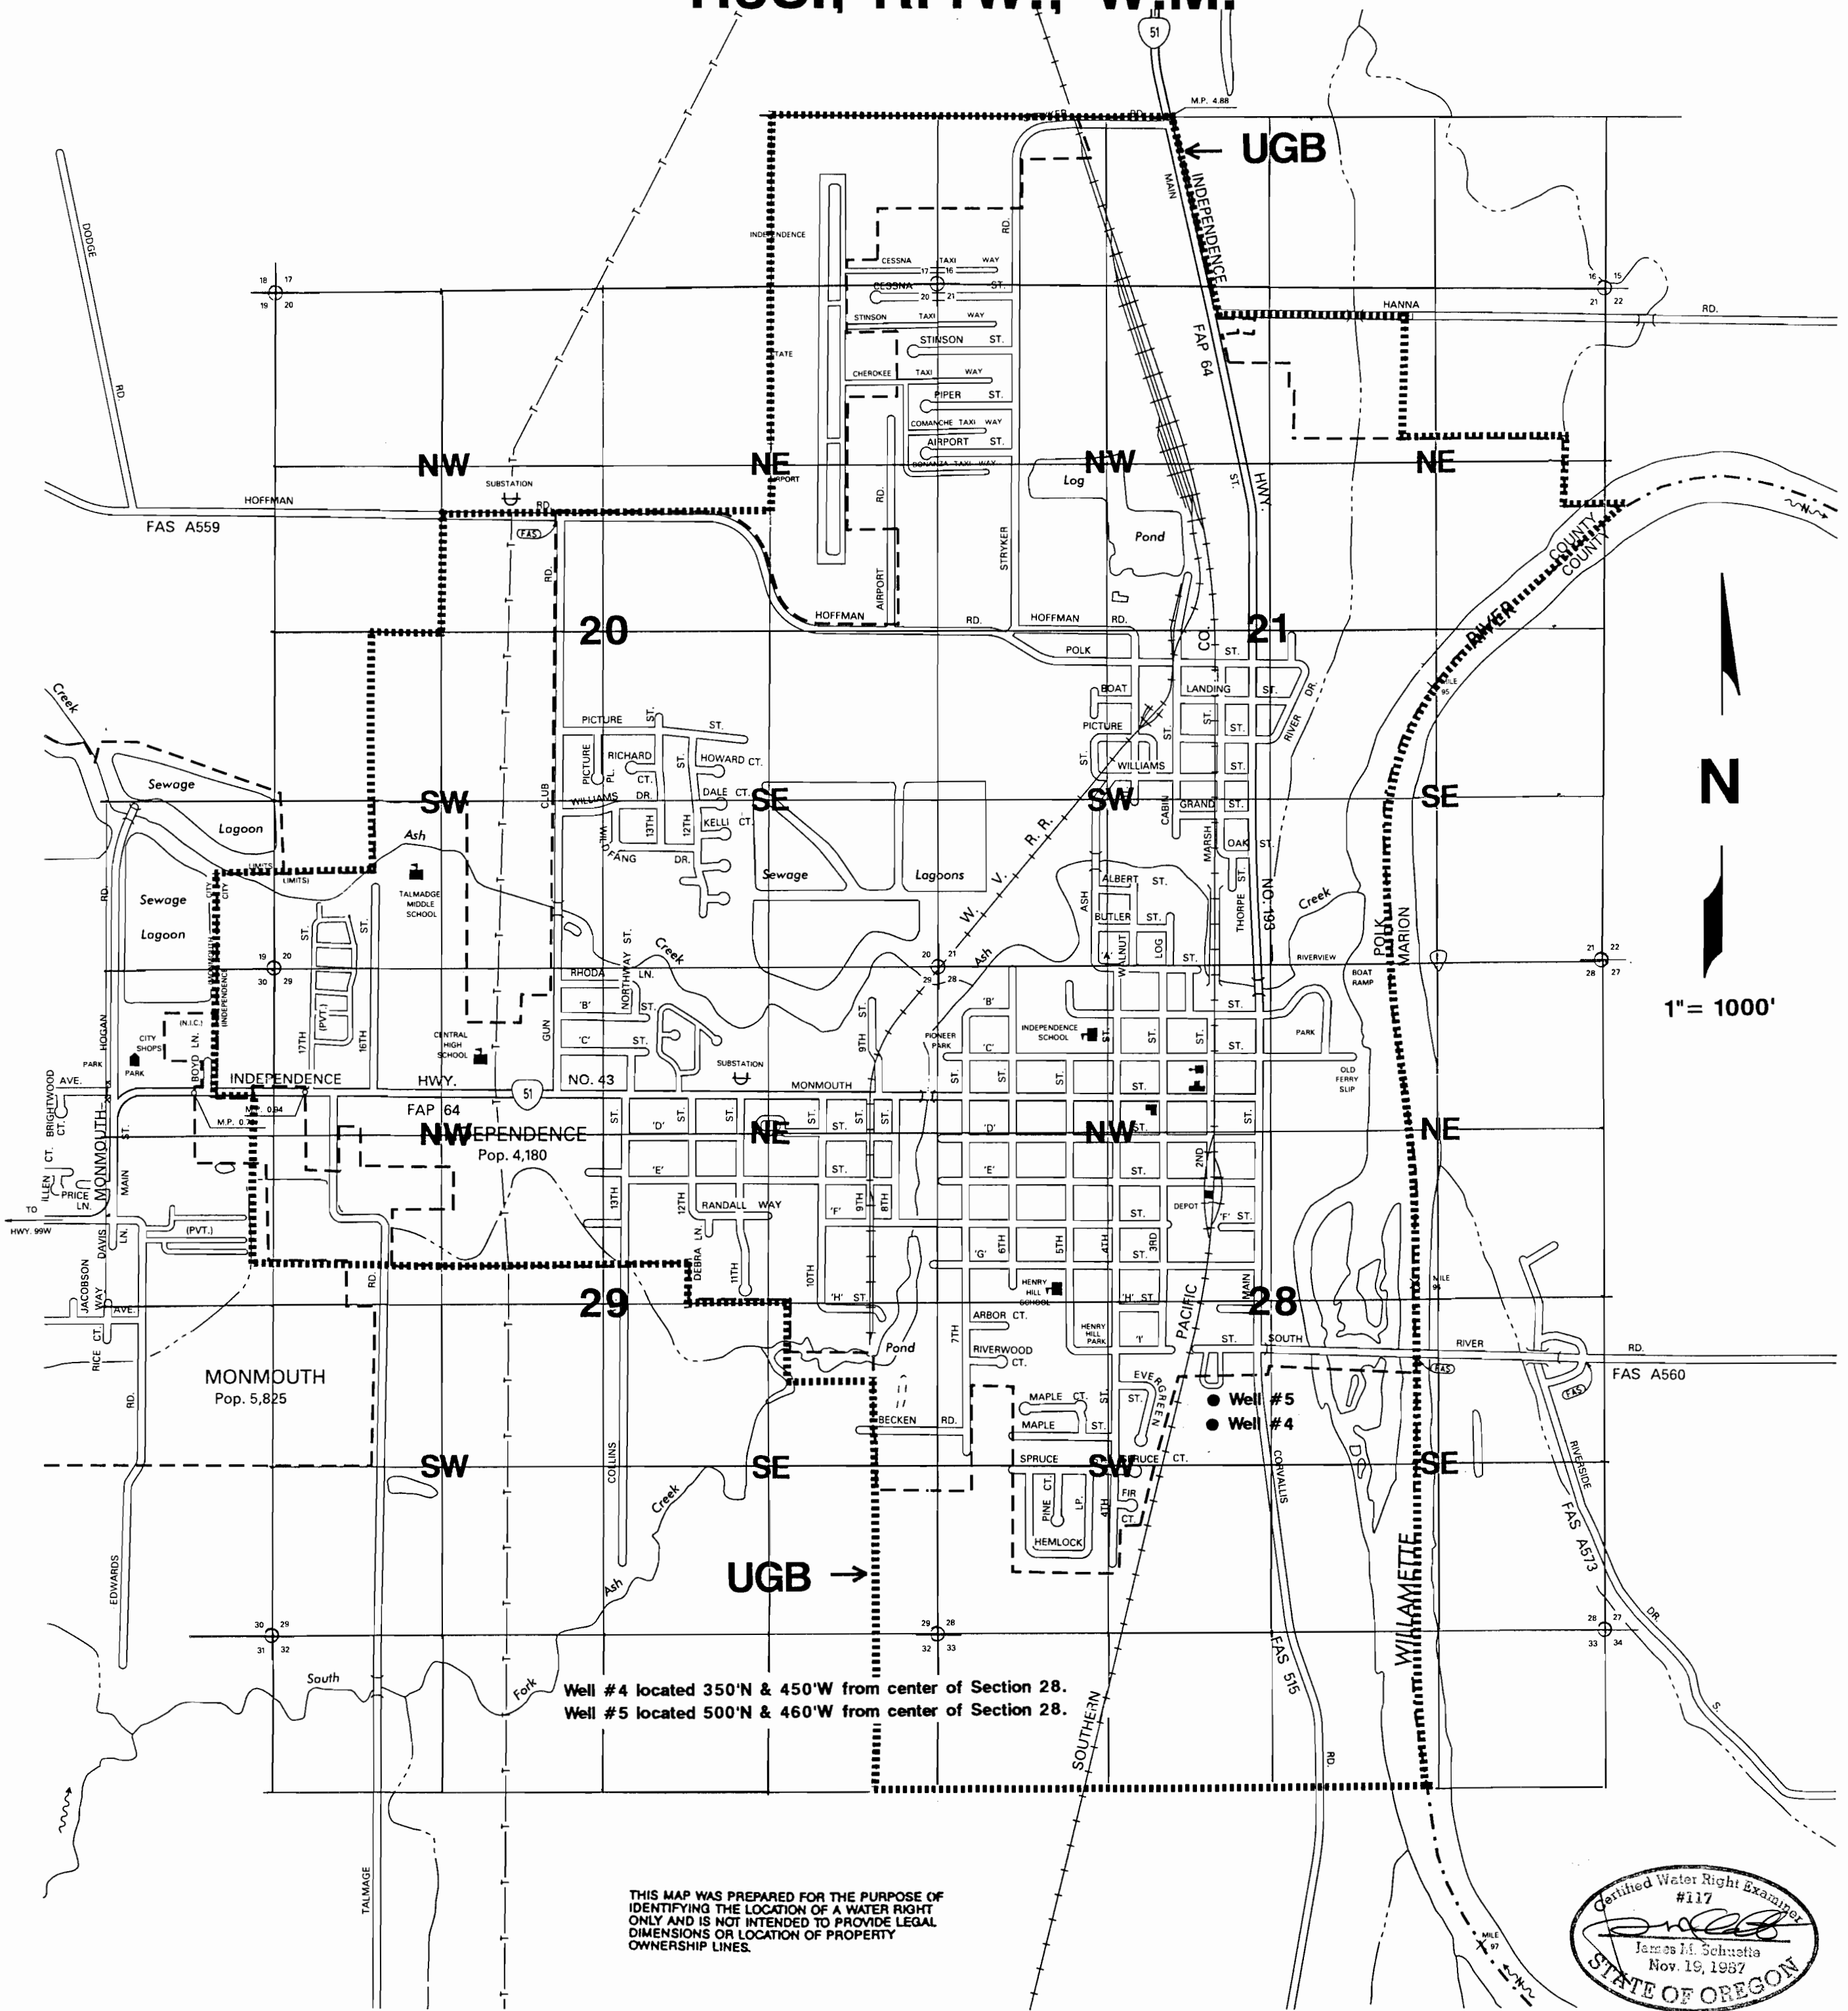

Certified Water Right Examiner
#117
James H. Schuetz
James H. Schuetz
Nov. 19, 1987
STATE OF OREGON

- DIVIDED HIGHWAY
- STREET OPEN FOR TRAVEL
- CITY LIMITS
- INTERSTATE ROUTE
- U.S. ROUTE
- STATE ROUTE
- TERMINATION OF FA SYSTEM
- PUBLIC BUILDING
- COURT HOUSE
- CITY HALL
- ARMORY
- POST OFFICE
- SCHOOL
- LIBRARY
- Urban Growth Boundary

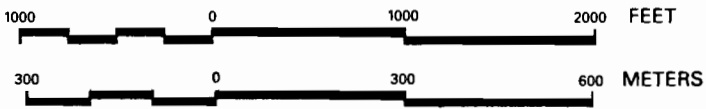

Application Map City of Independence

Application #: C-13871 Permit #: C18015