

Permit # ~~42833~~

01801F

613251

DUANE B. LINDSAY

P.O. BOX 1393

BARBOUR, OR 97111

### GROUNDWATER APPLICATION MAP

IN THE NAME OF DUANE B. LINDSAY

# 6-13215


SECTION 13, TOWNSHIP 29 SOUTH, RANGE 15 WEST, W.M.

TAX LOT 700

# RECEIVED

SEP - 9 1996

WATER RESOURCES DEPT.  
SALEM, OREGON

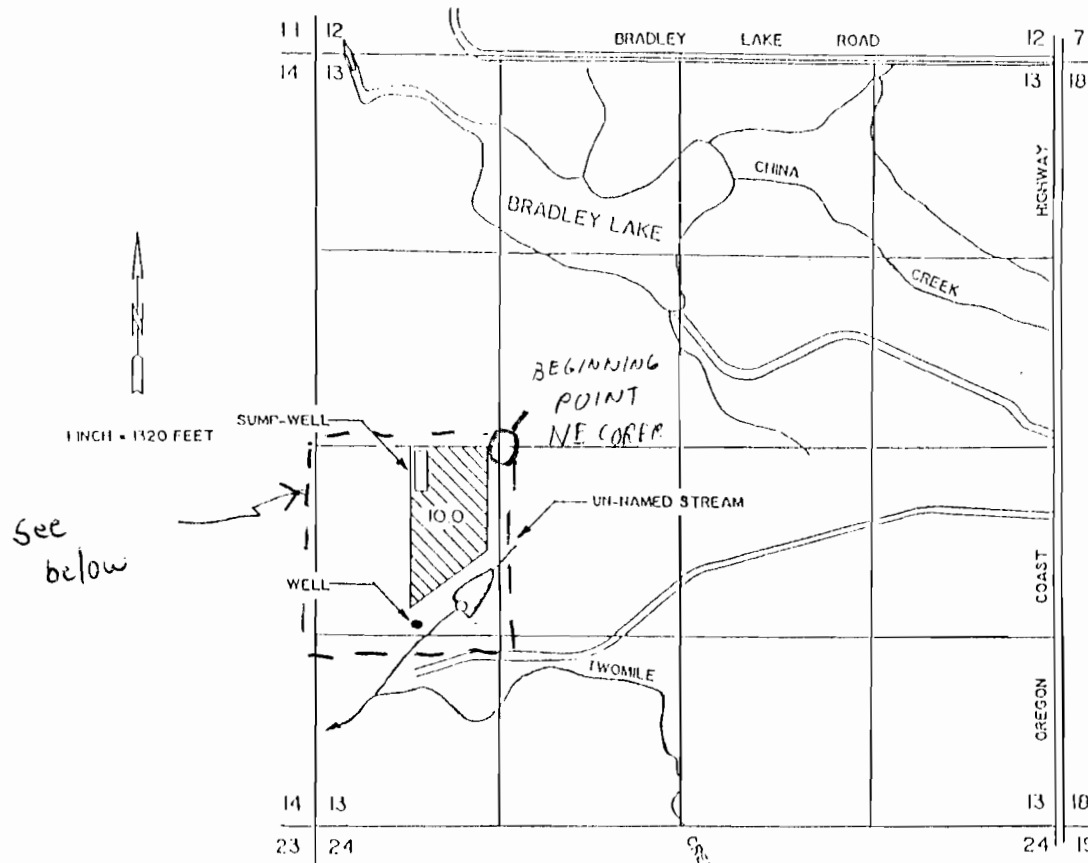

See below

