
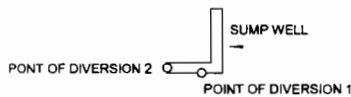


FINAL PROOF SURVEY MAP IN THE NAME OF ALAN A. HAGA

APPLICATION G-12450

PERMIT G-13020

SECTION 9, TOWNSHIP 31 SOUTH, RANGE 15 WEST, W.M.

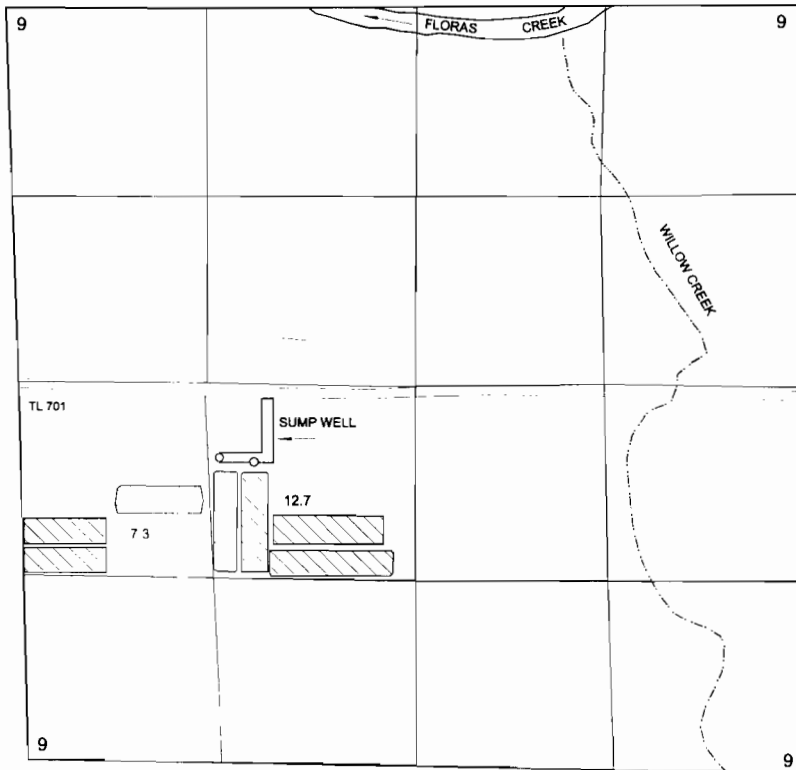

POINT OF DIVERSION No. 1 IS LOCATED 2070 FEET NORTH AND 1560 FEET EAST AND
POINT OF DIVERSION No. 2 IS LOCATED 2080 FEET NORTH AND 1310 FEET EAST; BOTH
FROM THE SOUTHWEST CORNER OF SECTION 9; BEING WITHIN THE NE $\frac{1}{4}$ SW $\frac{1}{4}$ OF
SECTION 9, TOWNSHIP 31 SOUTH, RANGE 15 WEST, W.M.; CURRY COUNTY.

