


# FINAL PROOF SURVEY MAP IN THE NAME OF ROBERT A. DONALDSON

APPLICATION G-13231

PERMIT G-13024

SECTION 15, TOWNSHIP 31 SOUTH, RANGE 15 WEST, W.M.

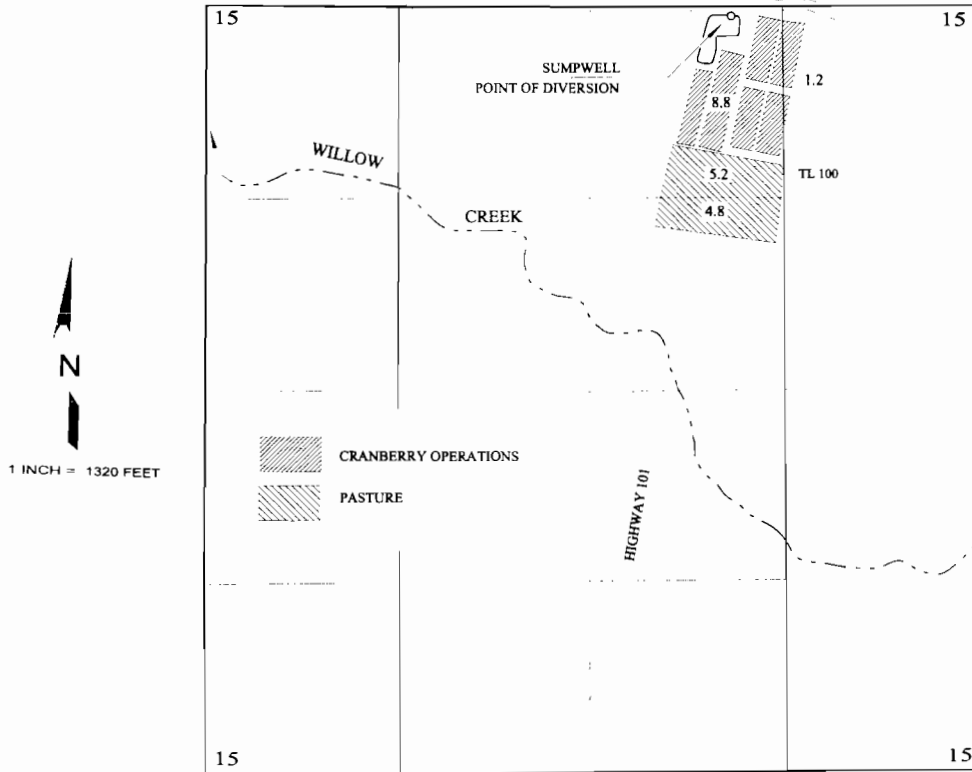

THE POINT OF DIVERSION IS LOCATED 80 FEET SOUTH AND 1680 FEET WEST FROM THE NORTHEAST CORNER OF SECTION 15, BEING WITHIN THE NW $\frac{1}{4}$ NE $\frac{1}{4}$  OF SECTION 15, TOWNSHIP 31 SOUTH, RANGE 15 WEST, W.M.; CURRY COUNTY.

**RECEIVED**  
SEP 25 2000  
WATER RESOURCES DEPT.  
SALEM, OREGON

THE PURPOSE OF THIS MAP IS TO IDENTIFY THE LOCATION OF THE WATER RIGHT. IT IS NOT INTENDED TO PROVIDE INFORMATION RELATIVE TO THE LOCATION OF PROPERTY OWNERSHIP BOUNDARY LINES.

*Robert A. Donaldson*  
Robert A. Donaldson  
JUL 14 1987  
WATER RESOURCES DEPT.  
SALEM, OREGON