


UMATILLA COUNTY

1" = 100'

See Map 2N 32 09

S.E. Cor. Wm. C. McKay
D.L.C. No 38

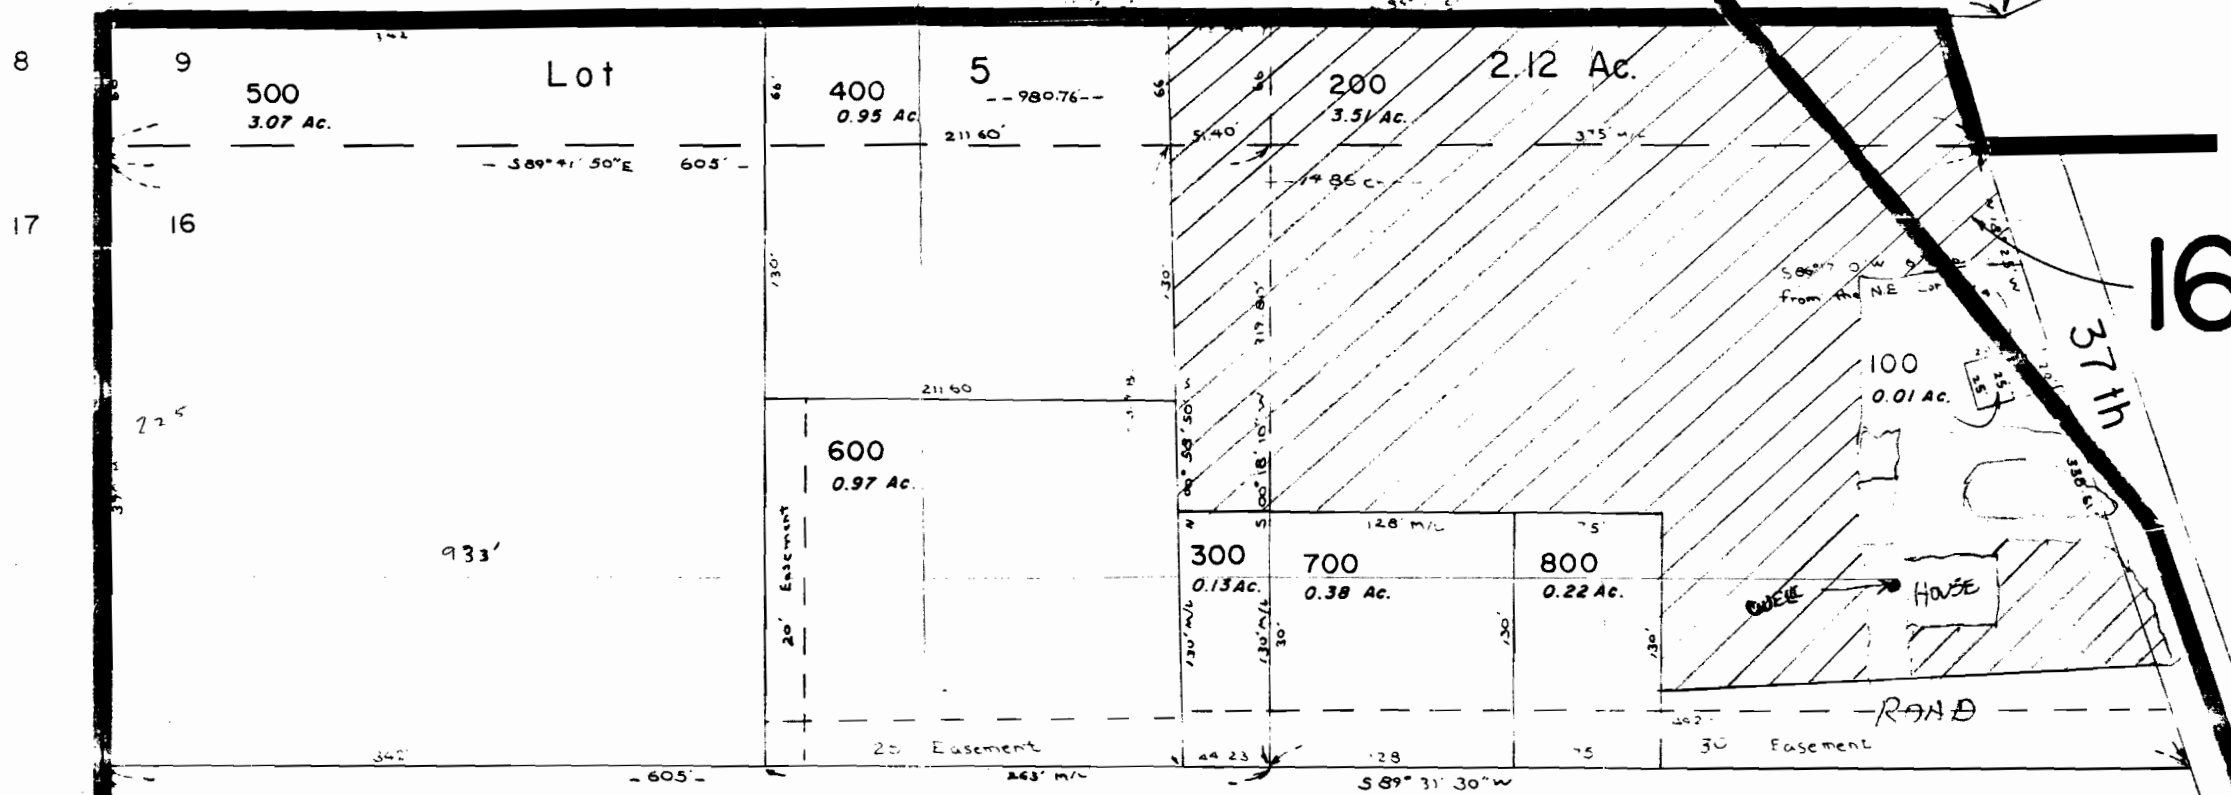

16-

37th

16-14.

APPLICATION: G 13842
PERMIT: G13011

/// - IRRIGATED AREA
ABOUT 3 ACRES

DR TERRY WOMACK
610 S.W. 37TH
PENDLETON OR 97801

WATER RESOURCES DEPT.
SALEM, OREGON

JUL 31 1995

RECEIVED

276-8728 OFFICE
276-6291 HOME