

T. 6 S. R. 2 W., W. M.

Application No. *6-14105*
 Permit No. **G13063**



4" = 1 MI.

RE-ENTRANT CORNER OF
 WEST LINE AUGUSTUS
 LAMBERT DLC 61

J.J. LEMMONS
 DLC 63

7 8
 18 17

INTERSTATE 5

WELL 8

• WELL 1

• WELL 6

WELL 4

WELL 5

WELL 2

BLDG.
 OCTAVE
 MARTEL
 DLC 65

• WELL 7

WELL 3

HARVEY
 SMITH
 DLC 66


BROOKLAKE RD.

RECEIVED

JUN 26 1995

WATER RESOURCES DEPT.
 SALEM, OREGON

J. PETIT
 DLC 75

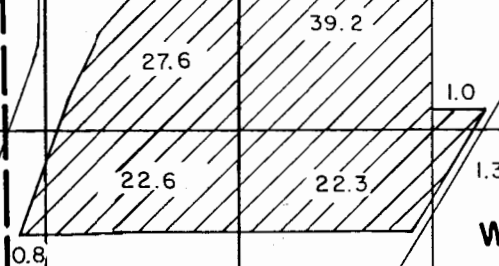

LINUS BROOKS
 DLC 64

WATER RIGHT MAP FOR
NORPAC FOODS, INC.
 (BROOKS PLANT)

WELL LOC. FROM RE-ENTRANT
 CORNER WEST LINE,
 AUGUSTUS LAMBERT DLC 61:

NO. 1	570' N. &	2850' E.
NO. 2	925' S. &	2800' E.
NO. 3	2840' S. &	2710' E.
NO. 4	920' S. &	2280' E.
NO. 5	890' S. &	2990' E.
NO. 6	2380' N. &	3930' E.
NO. 7	2640' S. &	1390' E.
NO. 8	210' S. &	1680' E.

THIS MAP WAS PREPARED FOR THE
 PURPOSE OF IDENTIFYING THE LOCA-
 TION OF A WATER RIGHT ONLY AND IS
 NOT INTENDED TO PROVIDE LEGAL
 DIMENSIONS OR LOCATION OF PROPER-
 TY OWNERSHIP LINES.

SURVEYED: *April 20, 1995*