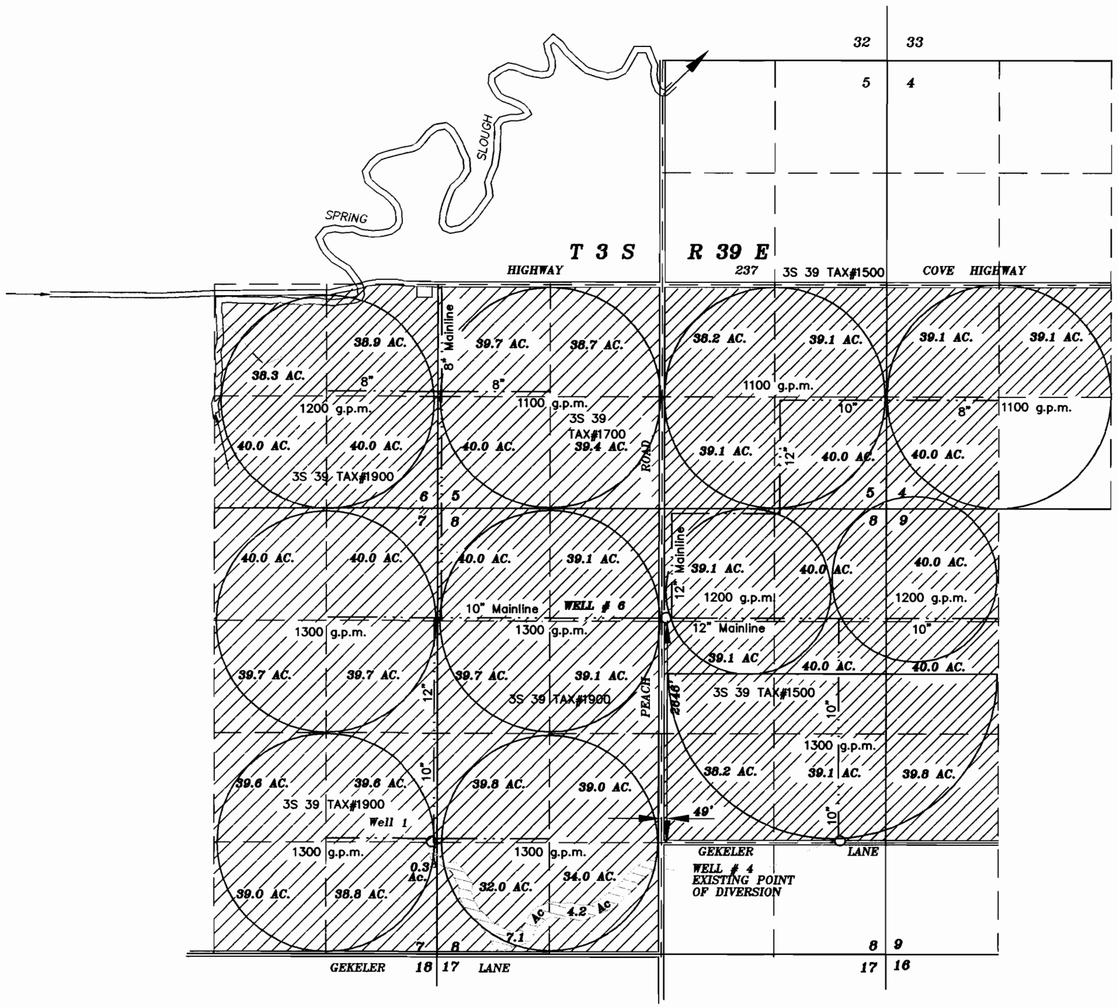

Lands irrigated with Primary water under Permit G-13066, from well number 6.

Lands irrigated with Supplemental water under Permit G-13066, from well number 6.

N

SCALE 1" = 1320 '

Certified Water Right Examiner
021
Gregory T. Blackman
Nov. 19, 1987
STATE OF OREGON

NOTE: The preparation of this map was for the purpose of identifying the location of the proposed water right and has no intent to provide dimensions or location of property ownership lines. Location information shown hereon was furnished by the applicant.

RECEIVED
WATER RESOURCES
SALEM, OREGON

September 22, 2004

FINAL MAP OF WATER RIGHTS FOR WELL NO. 6

FOR

WEISHAAR FARMS INCORPORATED
BY
BAGETT - GRIFFITH & BLACKMAN
2006 ADAMS AVENUE
LAGRANDE, OREGON 97850

APPLICATION NO. G-14027

PERMIT NUMBER G-13066

COBU MAP # 0146