
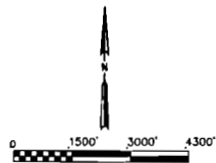


Well 2 - 1180' N & 780' W SE Corner Sec 23  
 Well 3 - 1130' N & 360' E SW Corner Sec 23  
 Well 4 - 1080' N & 1600' E SW Corner Sec 23  
 APDA Well 7 - 2240' S & 2180' E NW Corner Sec 25

**Figure 2**  
 POINTS OF APPROPRIATION  
 OWRD PERMIT G-13093  
 RIVERGATE INDUSTRIAL DISTRICT  
 NONPOTABLE WATER SYSTEM  
 PORT OF PORTLAND  
 PORTLAND, OREGON

**LEGEND:**  
 - - - - - RIVERGATE SERVICE AREA

**RECEIVED**  
 SEP 12 2002  
 WATER RESOURCES DEPT

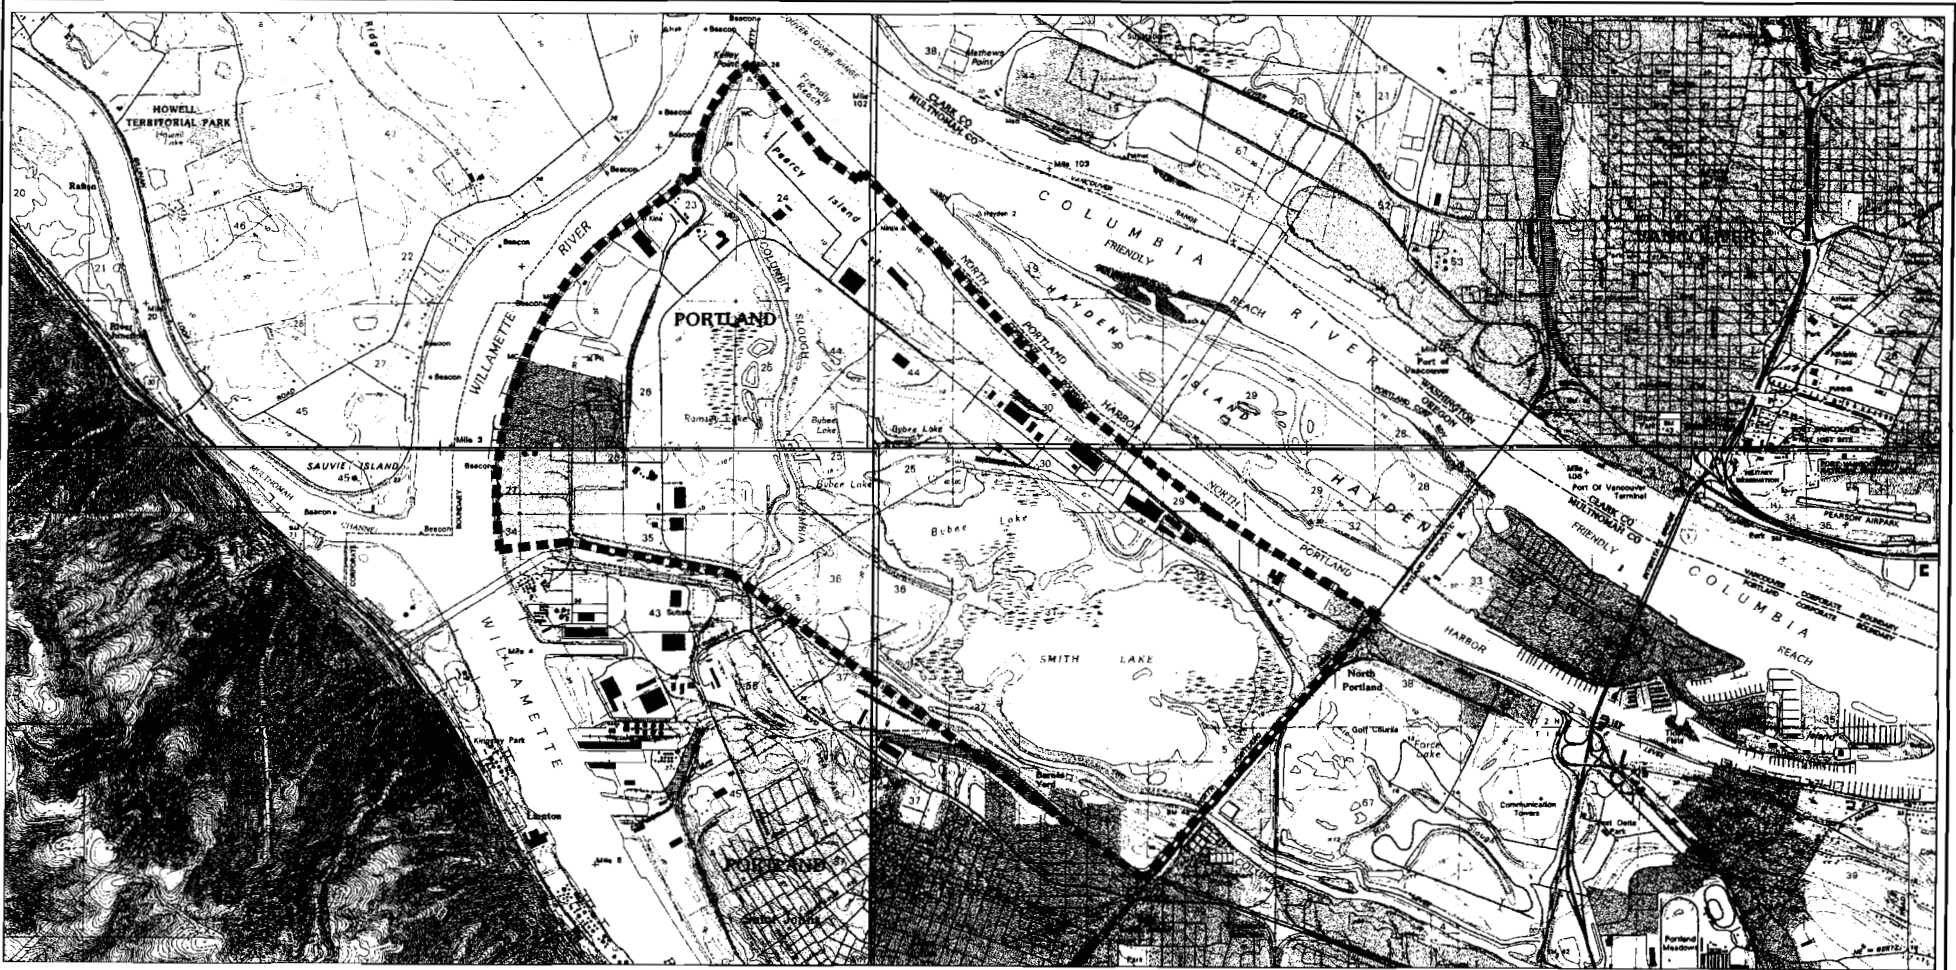

RECEIVED  
 SEP 12 2002  
 WATER RESOURCES DEPT  
 SALEM, OREGON

LEGEND:

■■■■■■■■■■ RIVERGATE SERVICE AREA

Figure 1  
 RIVERGATE INDUSTRIAL DISTRICT  
 SERVICE AREA  
 PORT OF PORTLAND  
 PORTLAND, OREGON