T.5S. R.1E. & R.1 W. W.M.

4" = 1 MI.

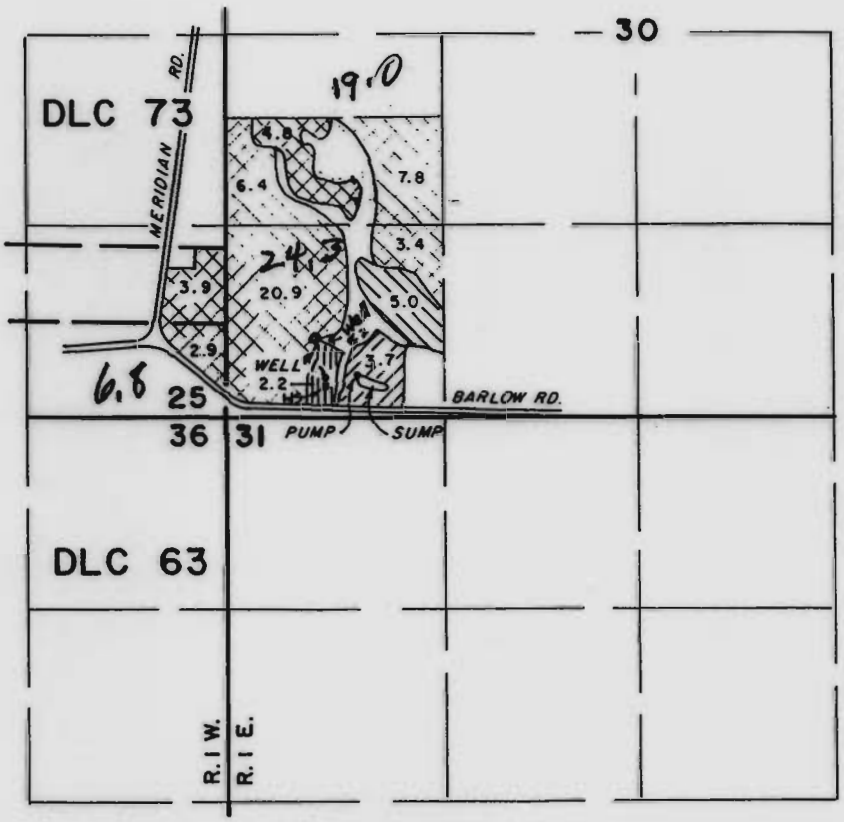

19.0
24.3
6.8
50.1

WORK COPY

IRRIG. FR. WELL, CERT. 50582 3.7

IRRIG. FR. SUMP, CERT. 50582 5.0

PRIMARY

IRRIG. FR. WELL, CERT. 45375 21.2

Suppl. 10.9 ac

WATER RIGHT MAP FOR

ILARION EFIMOFF

SURVEYED ON MAR. 30, 1992

BY: Larry W. Jerbrack

STATE OF OREGON

WELL 1 LOC. 270' N. & 700' E. FR. SW COR. SEC. 30
SUMP LOC. 280' N. & 910' E. " " " " "
WELL 2 LOC. [redacted]' N. & [redacted]' E. " " " " "

THIS MAP WAS PREPARED FOR THE PURPOSE OF IDENTIFYING THE LOCATION OF A WATER RIGHT ONLY AND IS NOT INTENDED TO PROVIDE LEGAL DIMENSIONS OR LOCATION OF PROPERTY OWNERSHIP LINES.