

TOWNSHIP 3 SOUTH, RANGE 1 WEST, W.M.

34

NW Cor
Bacheller, DLC

NW 1/4 SW 1/4

NE 1/4 SW 1/4

SE 30 2003

Road

Butteville
Station

Burlington
Northern
R.R.

TL 1800

116

SW 1/4 SW 1/4

SE 1/4 SW 1/4

Scale
1" = 400'

SW cor
Bacheller, DLC

3"
House
Well


Arndt Road 930'

S 1/4 corner

Surveyed Oct 1, 2002

Claim of Beneficial Use Map
for
FEMRITE NURSERY

App G-14201
Per G-13102

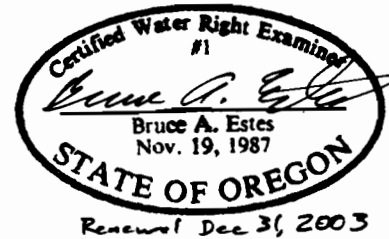

This map is for the purpose of
locating a water right only
and has no intent to provide
legal dimensions or the location
of property lines.

ESTES SURVEYS, LLC

PO Box 17519 60382 Arnold Rd
Salem, OR 97305-7519 Bend, OR 97702
(503) 585-7593 (541) 382-7391