

FINAL PROOF SURVEY

FOR APPLICATION G-12629
 PERMIT NO. G-13118

PLACE OF USE OF WATER
 USED FOR IRRIGATION AND LOCATED
 IN SECTION 12 TOWNSHIP 40 SOUTH,
 RANGE 18 EAST, AND IN SECTION 7,
 TOWNSHIP 40 SOUTH, RANGE 19 EAST, OF THE
 WILLAMETTE MERIDIAN IN LAKE COUNTY, OREGON


REVISION	BY

ANDERSON ENGINEERING AND SURVEYING, INC.
 P.O. BOX 28
 LAKEVIEW, OREGON 97630
 (541) 947-4407
 FAX 947-2321








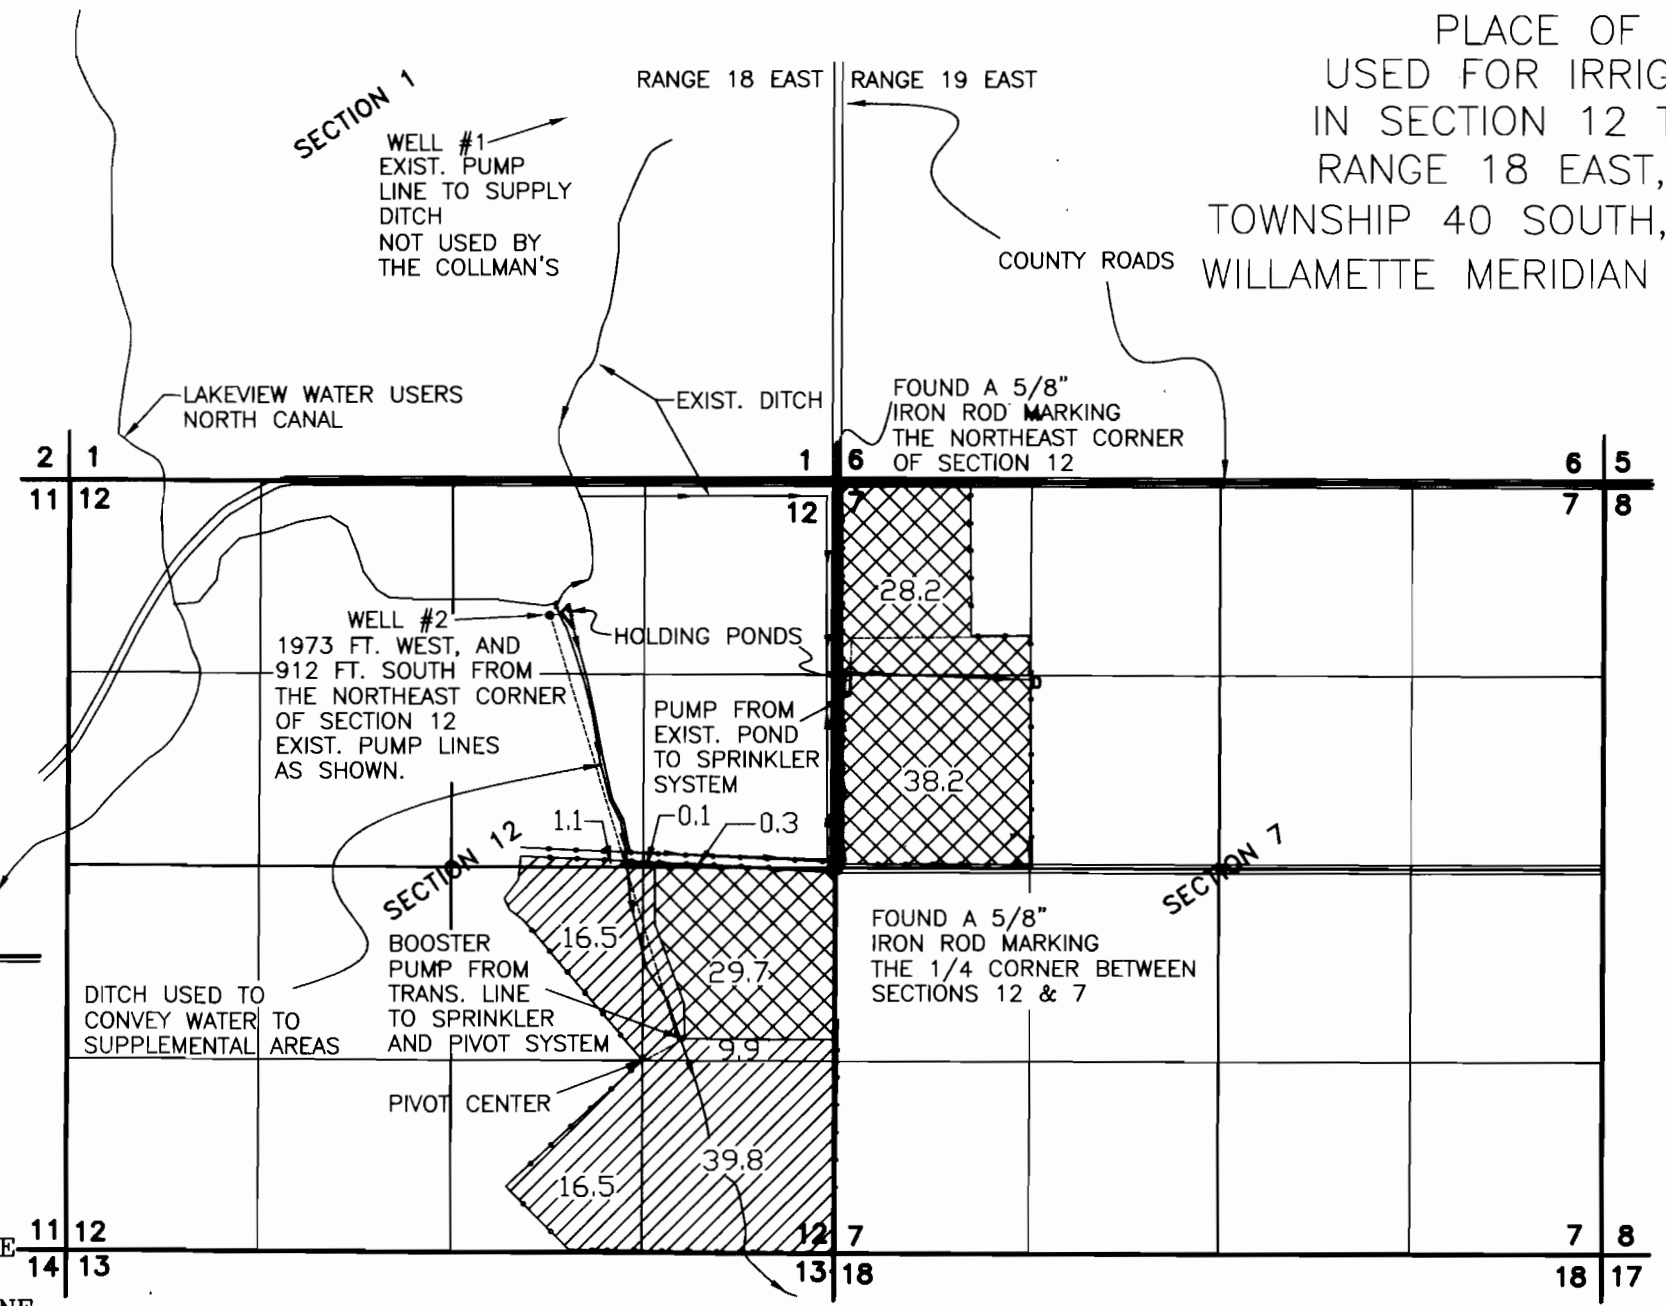



P.O. BOX 419
 REDMOND, OREGON 97756
 (541) 923-4307
 FAX 923-4308

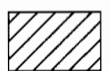

SCALE: 1"=1320'

 

LEGEND

-  PRIMARY WATER
-  SUPPLEMENTAL GROUND WATER WELL # 2
-  SECTION LINE
-  1/4 SECTION LINE
-  1/16 SECTION LINE
-  GOVERNMENT LOT LINES
-  EXISTING FENCE
-  WATER TRANSMISSION LINE
-  EXISTING DITCH
-  EXISTING WELL
-  FOUND LAND SURVEY MONUMENT AS NOTED.

SEE ACCOMPANYING
 SITE REPORT

NOTE: PREPARATION OF THIS MAP IS FOR IDENTIFYING PROPOSED WATER RIGHTS ONLY. IT HAS NO INTENT TO PROVIDE LOCATIONS OR DIMENSIONS OF PROPERTY BOUNDARIES.

RECEIVED



PREPARED FOR:
 RICHARD & LUCY COLLMAN
 HC 60 BOX 2900
 LAKEVIEW, OREGON 97630

DATE: 3/28/2000
SCALE: 1"=1320'
JOB: 2021
DWG. BY: M.J.B.
FILE: 2021FP
SHEET 1 OF 1

APR 20 2000

RENEWAL 12/31/2000