


TOWNSHIP 14 SOUTH, RANGES 13 & 14 EAST, W. M.


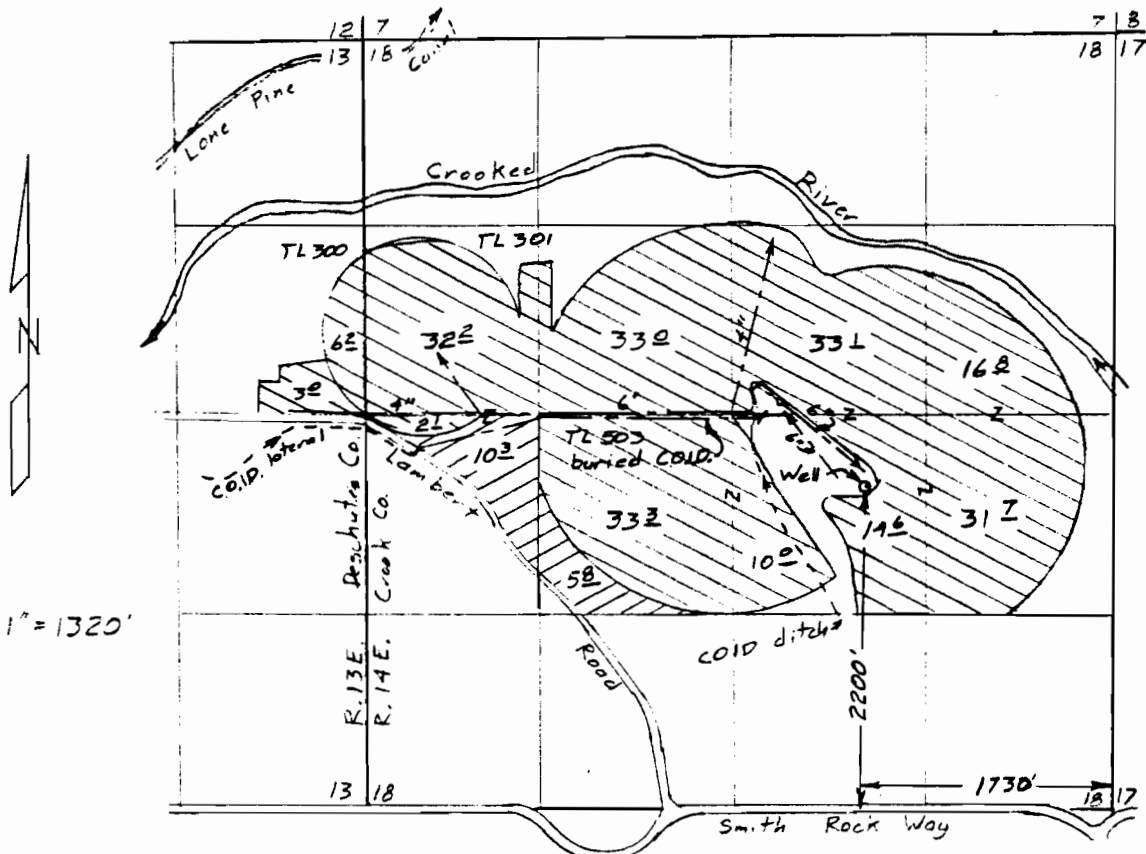


Scale 1" = 1320'

- ⊗ Supplemental to COID.
- ⊙ Primary

Surveyed June 19, 2000

Claim of Beneficial Use Map  
for  
Re - Gret, Inc.

 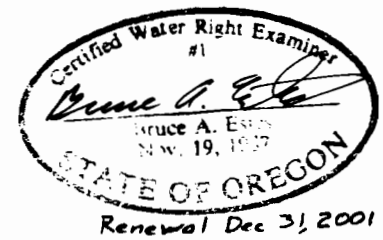

Application # G-13270

Permit # G-13122

This map is for the purpose of locating a water right only and has no intent to provide legal dimensions or the location of property lines.

**ESTES SURVEYS**  
 6293 Sunnyview Rd. NE 60382 Arnold Rd.  
 Salem, OR 97305 Bend, OR 97702  
 (503) 585-7593 (503) 382-7391