

T.1 S., R.44 E., W.M. &
T.2 S., R.44 E., W.M.
WALLOWA COUNTY, OREGON




SCALE: 1" = 400'

NOTE: THE PURPOSE OF THIS
MAP IS TO IDENTIFY THE
LOCATION OF THE WATER RIGHT.
IT IS NOT INTENDED TO PROVIDE
INFORMATION RELATIVE TO THE
LOCATION OF PROPERTY
OWNERSHIP BOUNDARY LINES.

CITY OF ENTERPRISE
WATER SERVICE DISTRICT
(PLACE OF USE)

WELL No. 1 IS 1590' NORTH AND 160'
EAST OF THE SOUTHWEST CORNER OF
SEC. 36, T.1S., R.44E. W.M. LOCATED IN
THE NW 1/4 OF THE SW 1/4 OF SEC. 36
(WELL No. 1 IS LOCATED IN TAX LOT #15
44 3403).

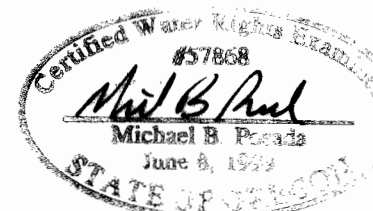

EXPIRATION DATE 12-31-04

DATED 01-24-03

RECEIVED

APR 07 2003

WATER RESOURCES DEPT.
SALEM, OREGON

CORRECTION MAP #0200
1 of 3

AUTHORIZED PLACE OF USE
UNDER PERMIT G-13126
TOWNSHIP 1 SOUTH, RANGE 44 EAST, W.M.
SECTION 34: NE 1/4, SE 1/4 & NW 1/4, SE
1/4 & SW 1/4, SE 1/4 & SE 1/4, SE 1/4
SECTION 35: NE 1/4, SE 1/4 & NW 1/4, SE
1/4 & SW 1/4, SE 1/4 & SE 1/4, SE 1/4 & NE
1/4, SW 1/4 & NW 1/4, SW 1/4 & SW 1/4, SW
1/4 & SE 1/4, SW 1/4.
SECTION 36: NE 1/4, SW 1/4 & NW 1/4, SW
1/4 & SW 1/4, SW 1/4 & SE 1/4, SW 1/4.
TOWNSHIP 2 SOUTH, RANGE 44 EAST, W.M.
SECTION 3: NE 1/4, NE 1/4 & SE 1/4, NE 1/4.
SECTION 2: NE 1/4, NE 1/4 & NW 1/4, NE 1/4
& SW 1/4, NE 1/4 & SE 1/4, NE 1/4 & NE 1/4,
NW 1/4 & NW 1/4, NW 1/4 & SW 1/4, NW 1/4
& SE 1/4, NW 1/4 & NE 1/4, SW 1/4 & NW
1/4, SW 1/4 & NE 1/4, SE 1/4 & NW 1/4, SE
1/4 & SW 1/4, SE 1/4 & SE 1/4, SE 1/4.
SECTION 1: NE 1/4, NW 1/4 & NW 1/4, NW 1/4
& SW 1/4, NW 1/4 & SE 1/4, NW 1/4 & NE
1/4, SW 1/4 & NW 1/4, SW 1/4 & SW 1/4, SW
1/4 & SE 1/4, SW 1/4.
SECTION 12: NE 1/4, NE 1/4 & NW 1/4, NE
1/4 & SW 1/4, NE 1/4 & SE 1/4, NE 1/4 & NE
1/4, NW 1/4 & NW 1/4, NW 1/4 & SW 1/4, NW
1/4 & SE 1/4, NW 1/4 & NE 1/4, SW 1/4 &
NW 1/4, SW 1/4 & SW 1/4, SW 1/4 & SE 1/4,
SW 1/4 & NE 1/4, SE 1/4 & NW 1/4, SE 1/4
& SW 1/4, SE 1/4 & SE 1/4, SE 1/4.

LAST UPDATED: 01/24/03

2000
Anderson
Associates, Inc.

CLAIM OF BENEFICIAL USE MAP
CITY OF ENTERPRISE
WELL NO. 1
WALLOWA COUNTY, OREGON

FIGURE
1 OF 3

APPLICATION: G-14197
PERMIT: G-13126
DATE OF SURVEY: JUNE, 1997

J# 608-50-011

PATH: Q:/ENTERPRISE/WATERRIGHTS03/DWG/WICBU03.DWG

T.1 S., R.44 E., W.M. &
T.2 S., R.44 E., W.M.
WALLOWA COUNTY, OREGON

1/4 COR
BETWEEN SEC.34 &
SEC. 35

CITY OF ENTERPRISE
WATER SERVICE DISTRICT
(PLACE OF USE)
SEE SHEET 1 OF 3 FOR
PLACE OF USE
DESCRIPTION.

RECEIVED

APR 07 2003

WATER RESOURCES DEPT.
SALEM, OREGON

SCALE: 1" = 1320'


T. 1 S.
T. 2 S.

SEC. 33 SEC. 34
SEC. 4 SEC. 3

SEC. 3 SEC. 2

SEC. 10 SEC. 11

SEC. 2
SEC. 11

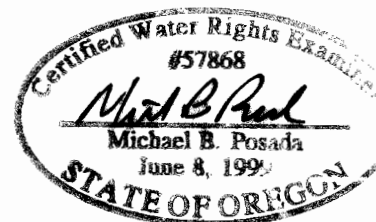

EXPIRATION DATE 12-31-04

DATED 01-24-03

J# 608-50-011

APPLICATION: G-14197
PERMIT: G-13126
DATE OF SURVEY: JUNE, 1997

LAST UPDATED: 01/24/03




CLAIM OF BENEFICIAL USE MAP
CITY OF ENTERPRISE
WELL NO. 1
WALLOWA COUNTY, OREGON

FIGURE
2 OF 3

CORRECTION MAP #
0200
2 of 3

NOTE: THE PURPOSE OF THIS
MAP IS TO IDENTIFY THE
LOCATION OF THE WATER RIGHT.
IT IS NOT INTENDED TO PROVIDE
INFORMATION RELATIVE TO THE
LOCATION OF PROPERTY
OWNERSHIP BOUNDARY LINES.

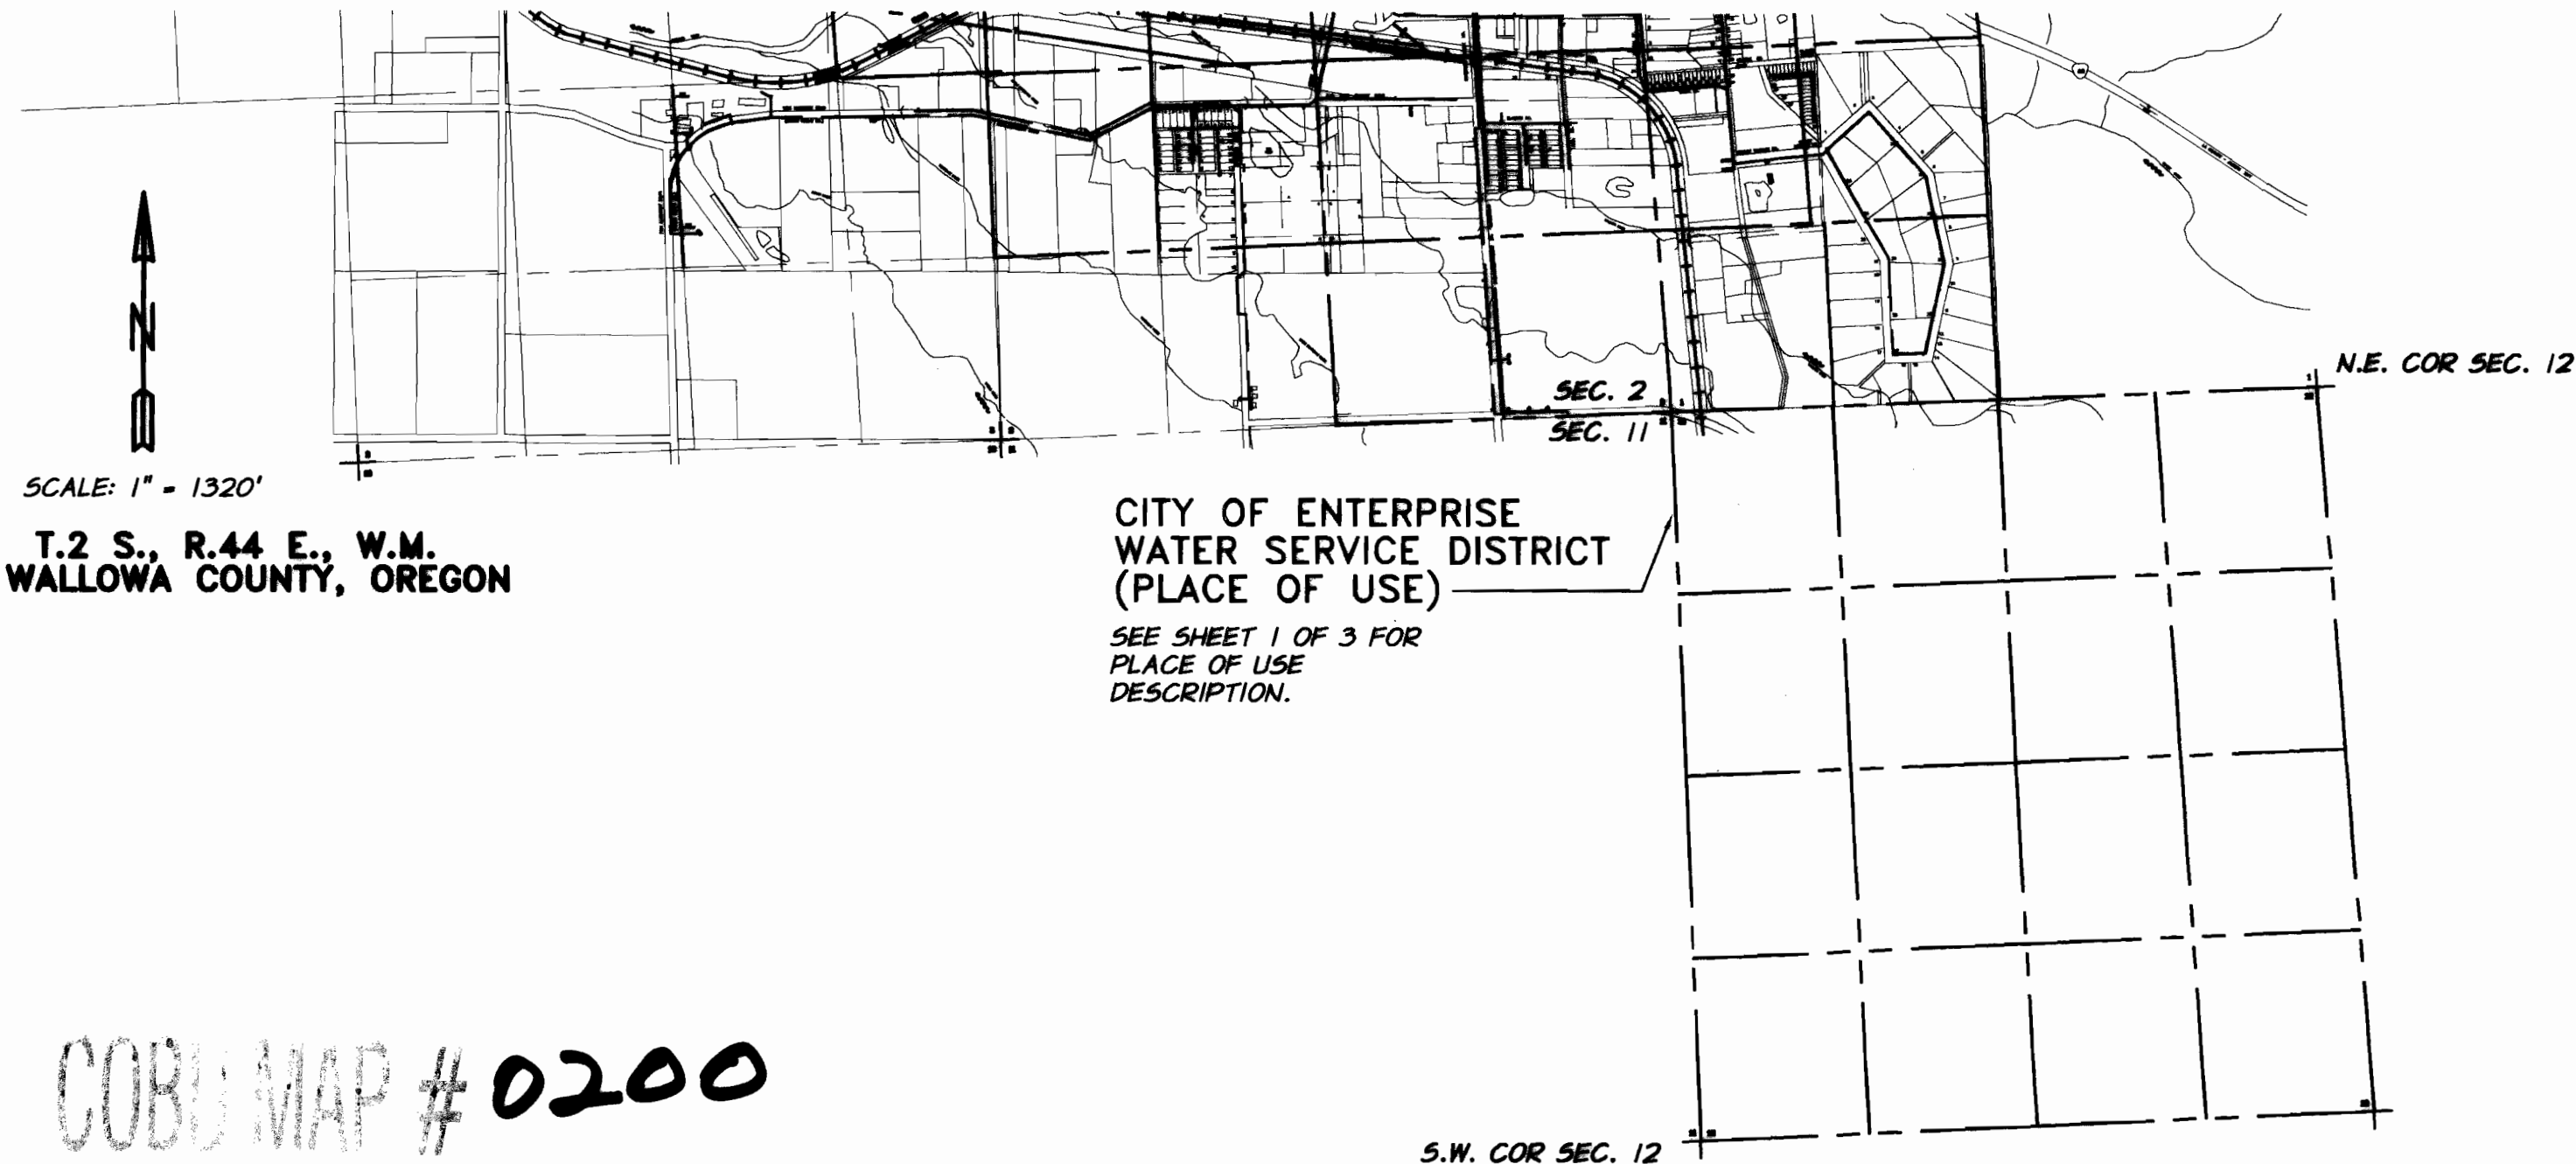

SCALE: 1" = 1320'


T.2 S., R.44 E., W.M.
WALLOWA COUNTY, OREGON

CITY OF ENTERPRISE
WATER SERVICE DISTRICT
(PLACE OF USE)

SEE SHEET 1 OF 3 FOR
PLACE OF USE
DESCRIPTION.

COB MAP #0200
3 of 3

NOTE: THE PURPOSE OF THIS
MAP IS TO IDENTIFY THE
LOCATION OF THE WATER RIGHT.
IT IS NOT INTENDED TO PROVIDE
INFORMATION RELATIVE TO THE
LOCATION OF PROPERTY
OWNERSHIP BOUNDARY LINES.

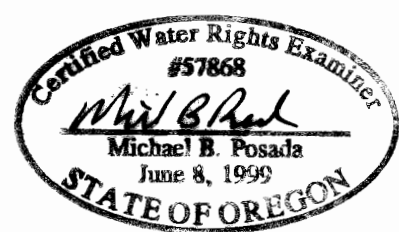

EXPIRATION DATE: 12-31-01

DATED 01-24-03

J# 608-50-011

RECEIVED

APR 07 2003

WATER RESOURCES DEPT.
SALEM, OREGON

APPLICATION: G-14197
PERMIT: G-13126
DATE OF SURVEY: JUNE, 1997

LAST UPDATED: 01/24/03



CLAIM OF BENEFICIAL USE MAP
CITY OF ENTERPRISE
WELL NO. 1
WALLOWA COUNTY, OREGON

FIGURE
3 OF 3