


APR 1 1999

T.16S. R.4W. W.M.

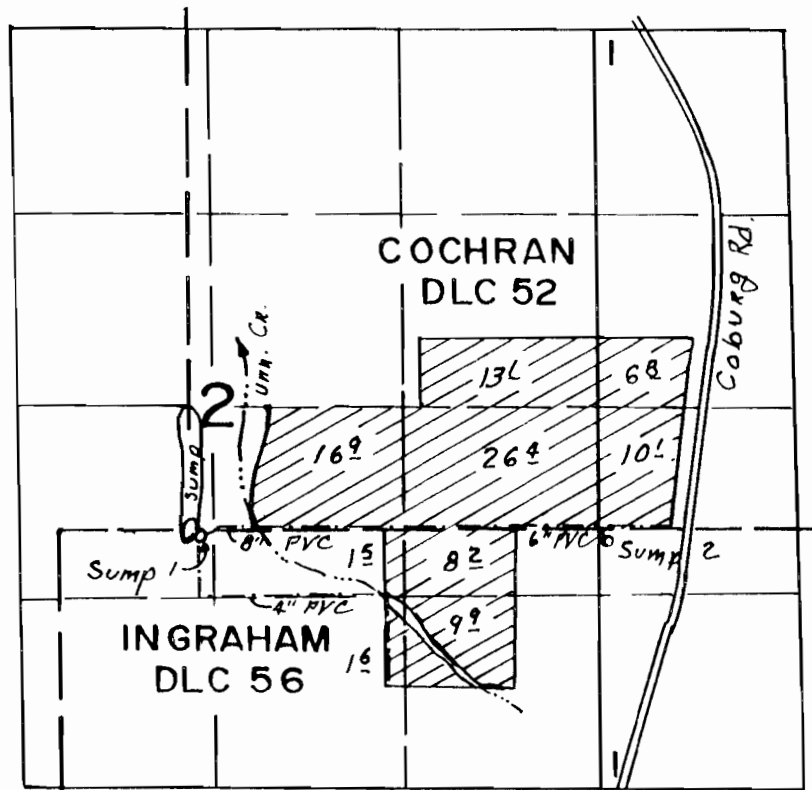


Sump 1 Loc. 10'S & 910' E FROM NW COR. DLC 56
 Sump 2 Loc. 108'S & 3740' E " " " " " "

FINAL PROOF SURVEY UNDER

G-12525 G-11996
 Application No. G-14257 Permit No. G-13141
 IN NAME OF

HAYWORTH FARMS INC.

Surveyed JUNE 9 1999, by

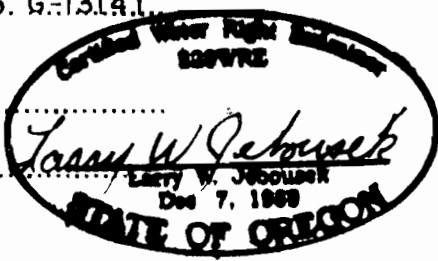

THIS MAP WAS PREPARED FOR THE PURPOSE OF IDENTIFYING THE LOCATION OF A WATER RIGHT ONLY AND IS NOT INTENDED TO PROVIDE LEGAL DIMENSIONS OR LOCATION OF PROPERTY OWNERSHIP LINES.