
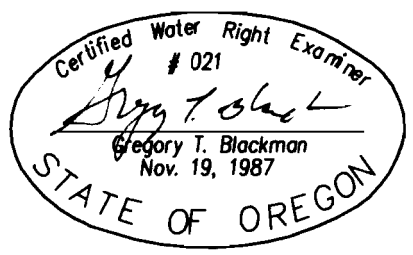


SCALE 1" = 1320'

 Lands with primary water from new well.



NOTE: The preparation of this map was for the purpose of identifying the location of the proposed water right and has no intent to provide dimensions or location of property ownership lines. Location information shown hereon was furnished by the applicant.

RECEIVED
MAY 23 2002

WATER RESOURCES DEPT
SALEM, OREGON

FINAL PROOF MAP FOR
WATER RIGHT
FOR
DWIGHT & ROBEN ARNOLDUS
TRI- CO FARMS PARTNERSHIP
BY
BAGETT - GRIFFITH & ASSOCIATES
2006 ADAMS AVENUE
LAGRANDE, OREGON 97850

MARCH 27, 2002

APPLICATION NO: G - 13989
PERMIT NUMBER G - 13146