

# FINAL PROOF SURVEY MAP


## WENDELL KREDER JR

Application # G-12385 Permit # G-13147

RECEIVED

WATER RESOURCES DIV  
DM 03815

### T 9 S, R 3 W, W.M. Sections 29,31,32

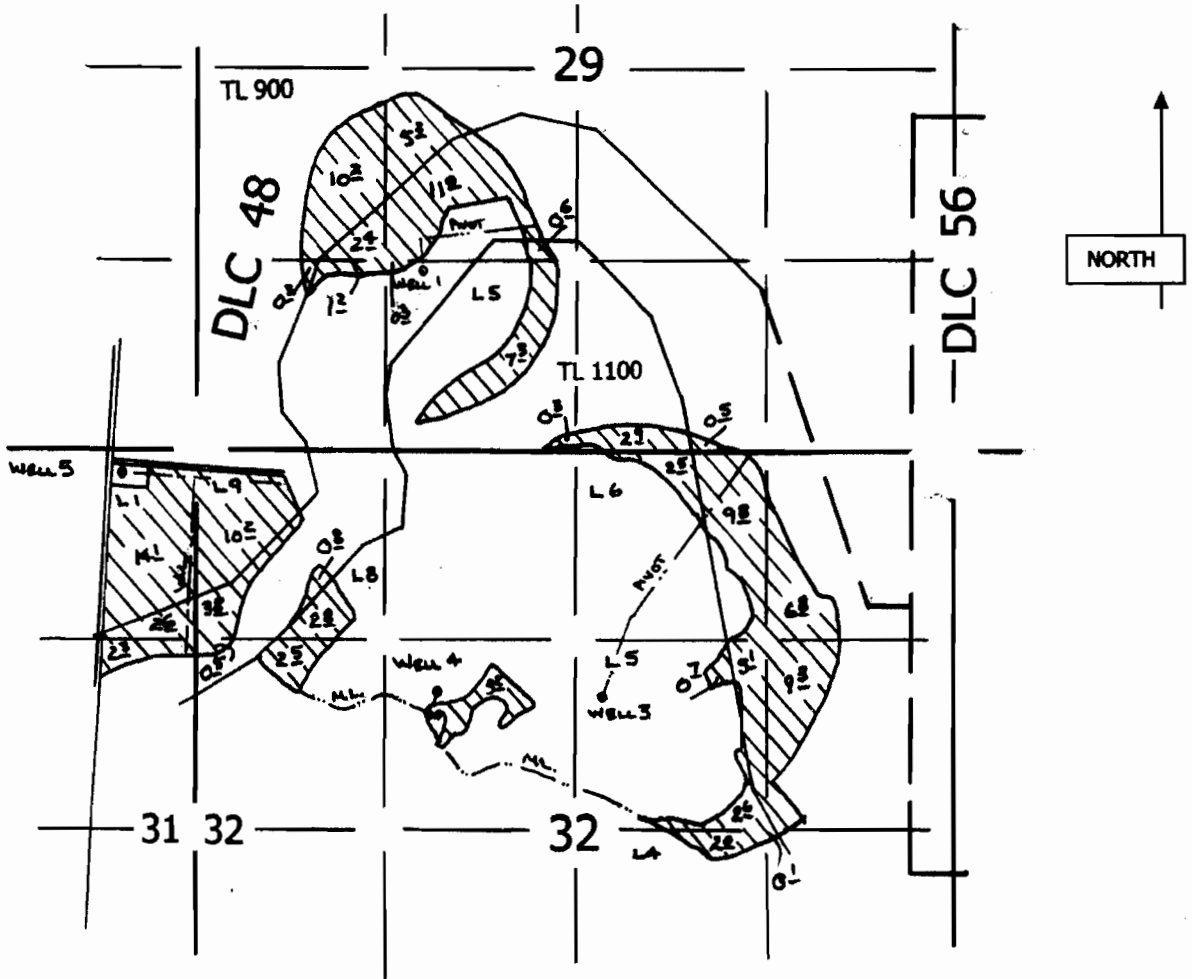

Well 1: 3410' W & 1040' S  
Well 3: 2125' W & 4010' S  
Well 4: 3290' W & 3980' S  
Well 5: 5475' W & 2475' S  
All from the NW corner DLC 56  
Measuring devise at or near wells.  
Scale 1" = 1320'



This map is not intended to provide legal dimensions or locations of property ownership lines .

RENEWAL DATE: 6-30-2009