


1" = 1320'  
 T 6N, R 35E, SEC 27  
 UMATILLA CO., OREGON

THIS MAP IS BASED ON USGS QUADMAP,  
 ASSESSOR MAP 6N 35 27C, FIELD MEASUREMENT.  
 IT IS PREPARED FOR WATER RIGHT PURPOSES  
 ONLY AND SHOULD NOT BE USED FOR  
 PROPERTY LOCATION PURPOSES.

WATER RESOURCES DEPT  
 SALEM OREGON

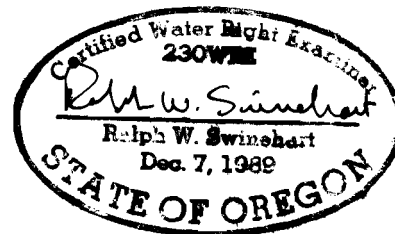

FINAL PROOF MAP  
 WELL WATER RIGHT PERMIT G-13156  
 FOR: FLOYD & SHARON HOOFARD  
 PO BOX 757  
 JOSEPH, OREGON 97846

PREPARED BY:  
 WALLOWA MOUNTAIN ENGINEERING  
 PO BOX 266  
 ENTERPRISE, OREGON 97828  
 PH: 541-424-4085

10/23/06