



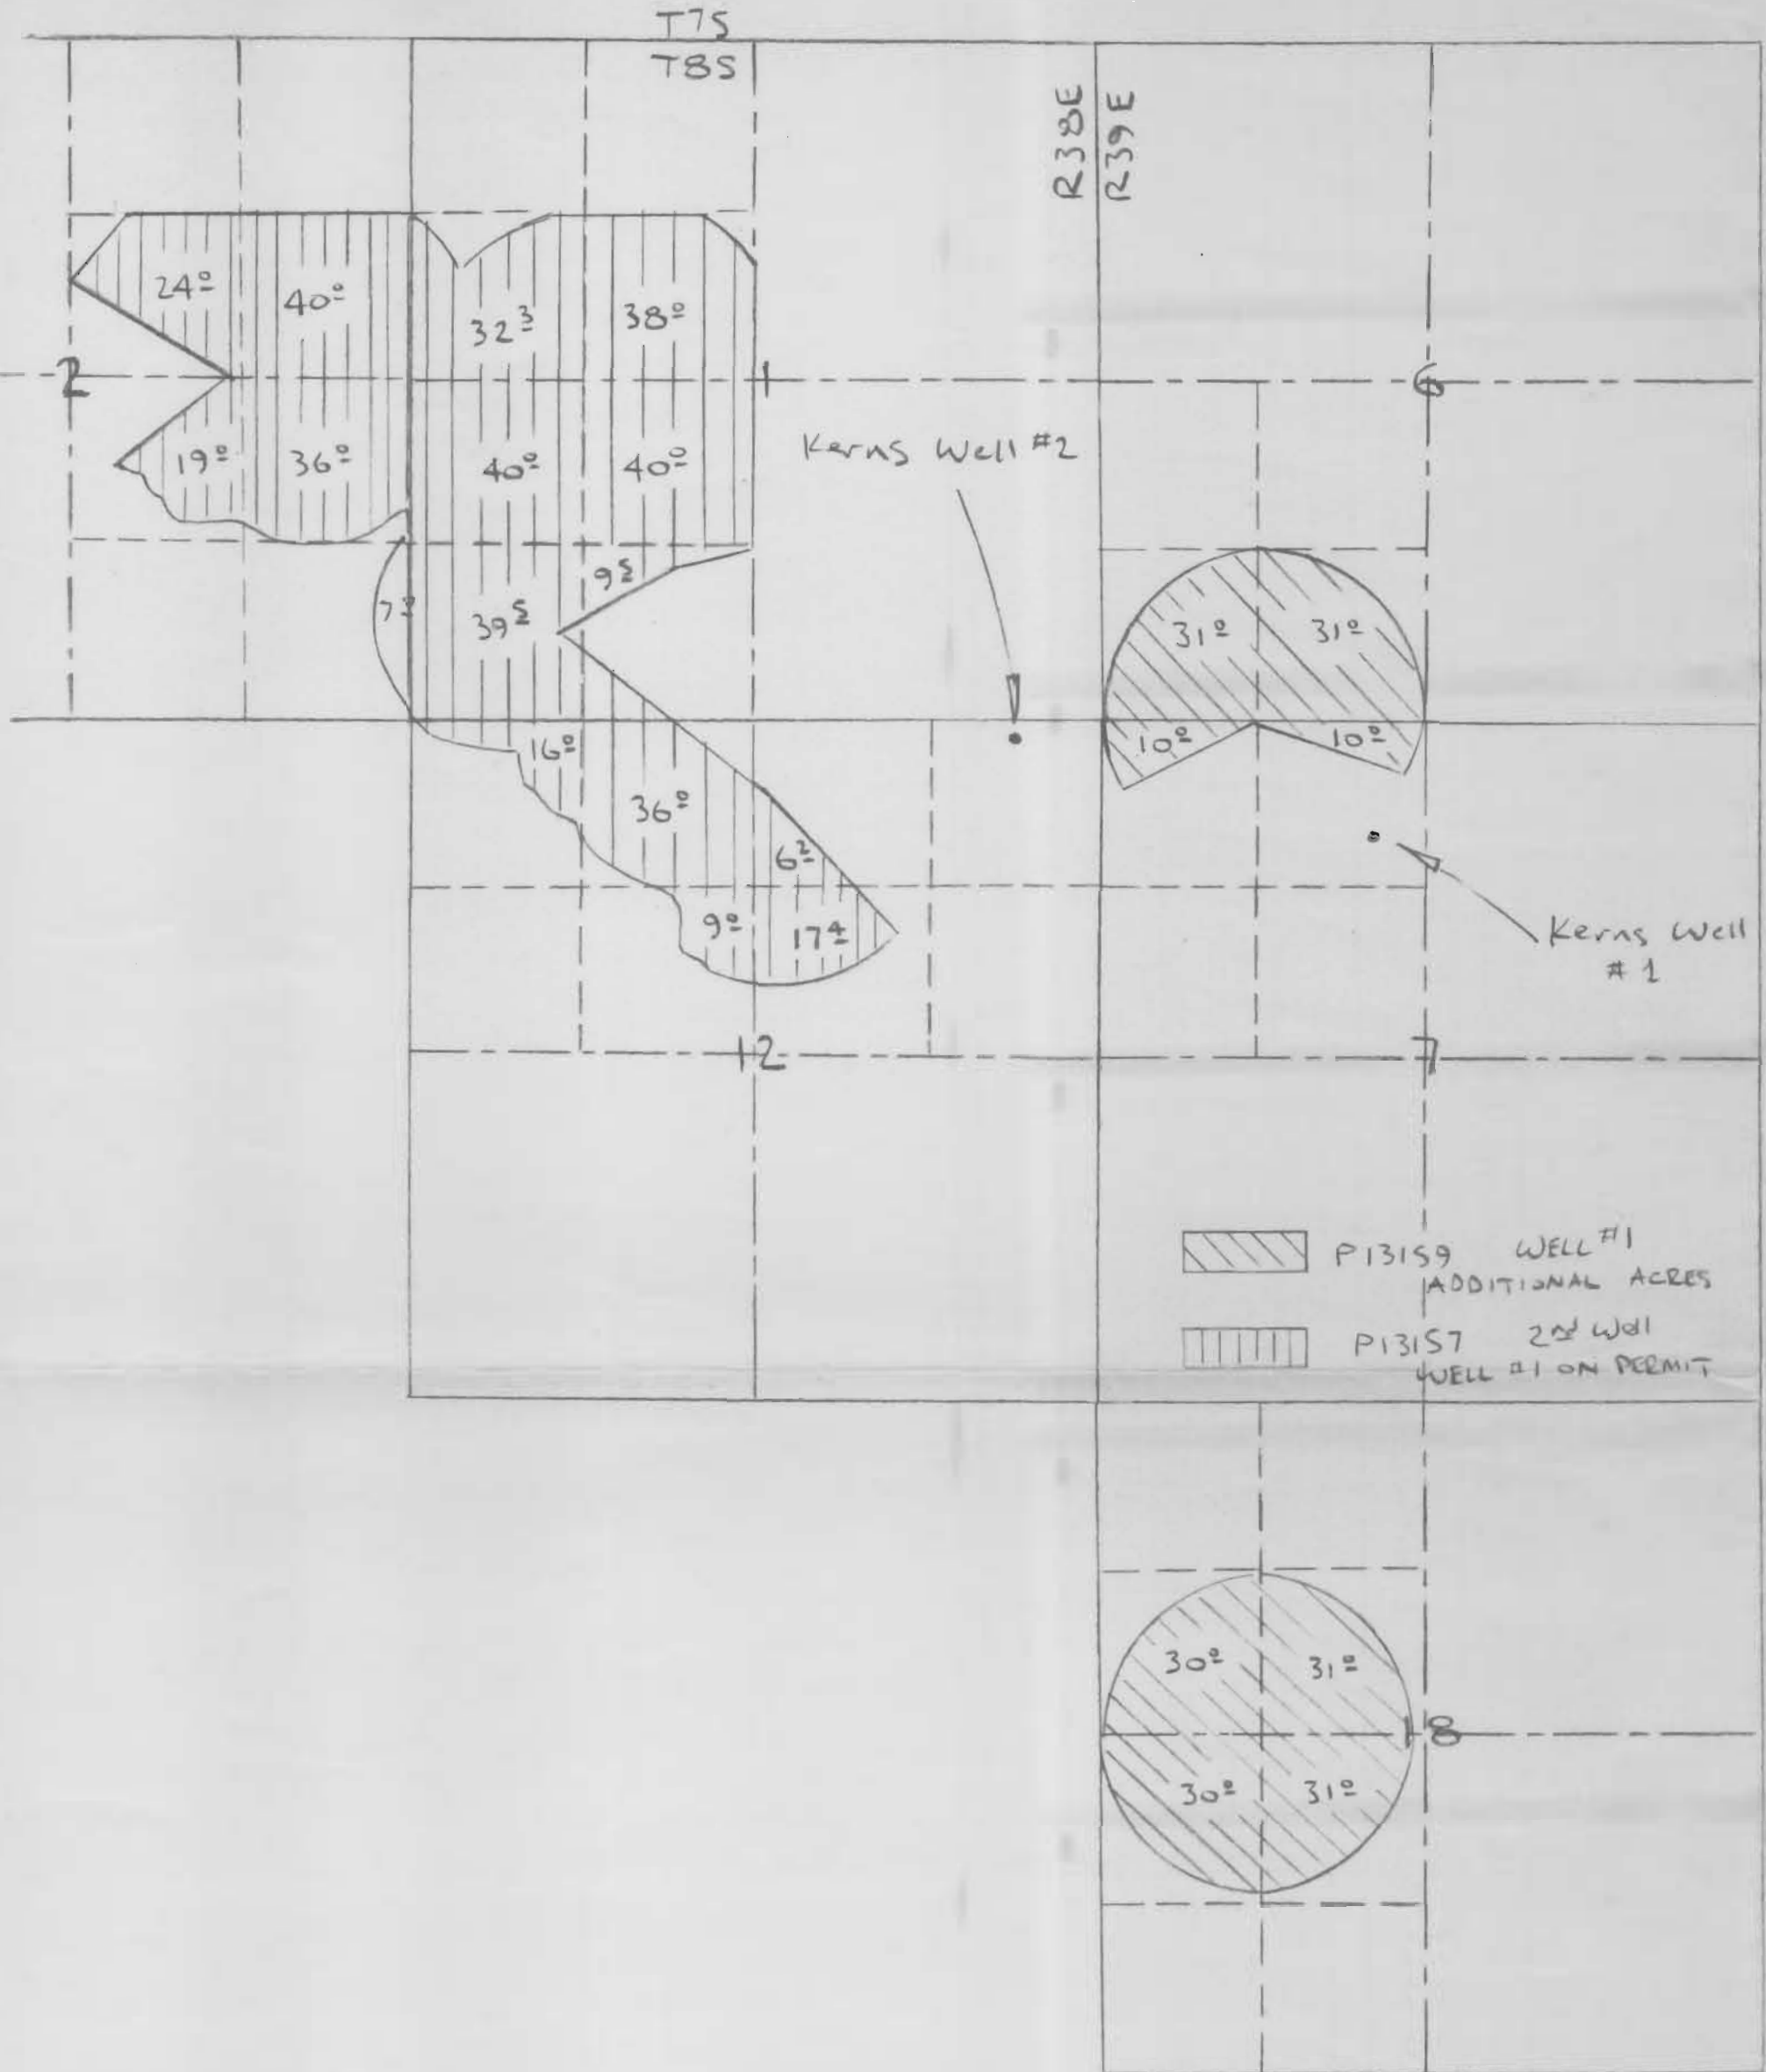

1" = 1320'

G. 13794

T. 8S., R. 39 E.

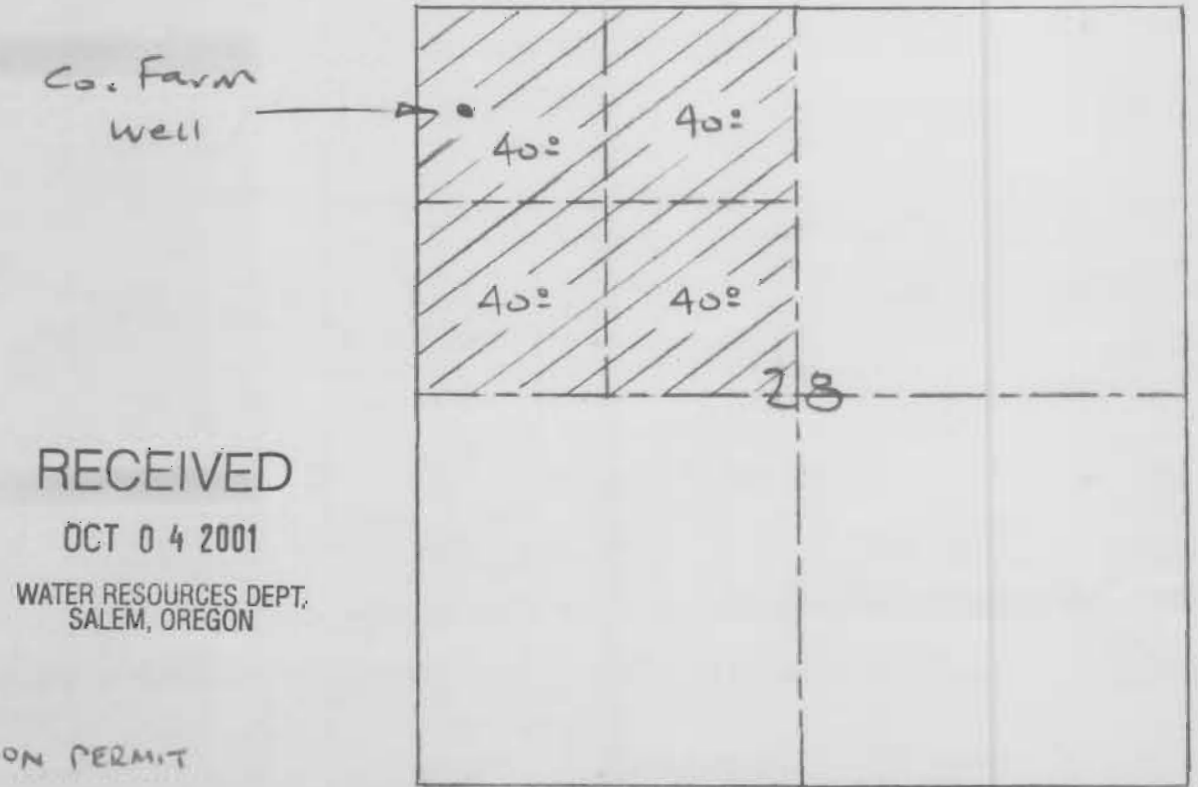

RECEIVED
OCT 04 2001
WATER RESOURCES DEPT.
SALEM, OREGON

FINAL PROOF SURVEY

IN THE NAME OF

KERNS RAINBOW RANCH
§ TIM AND JAN KERNS

OCT. 1, 2001

Thomas J. Haley