


TOWNSHIP 9 SOUTH, RANGE 3 WEST, W.M.
SE 1/4 SECTION 28

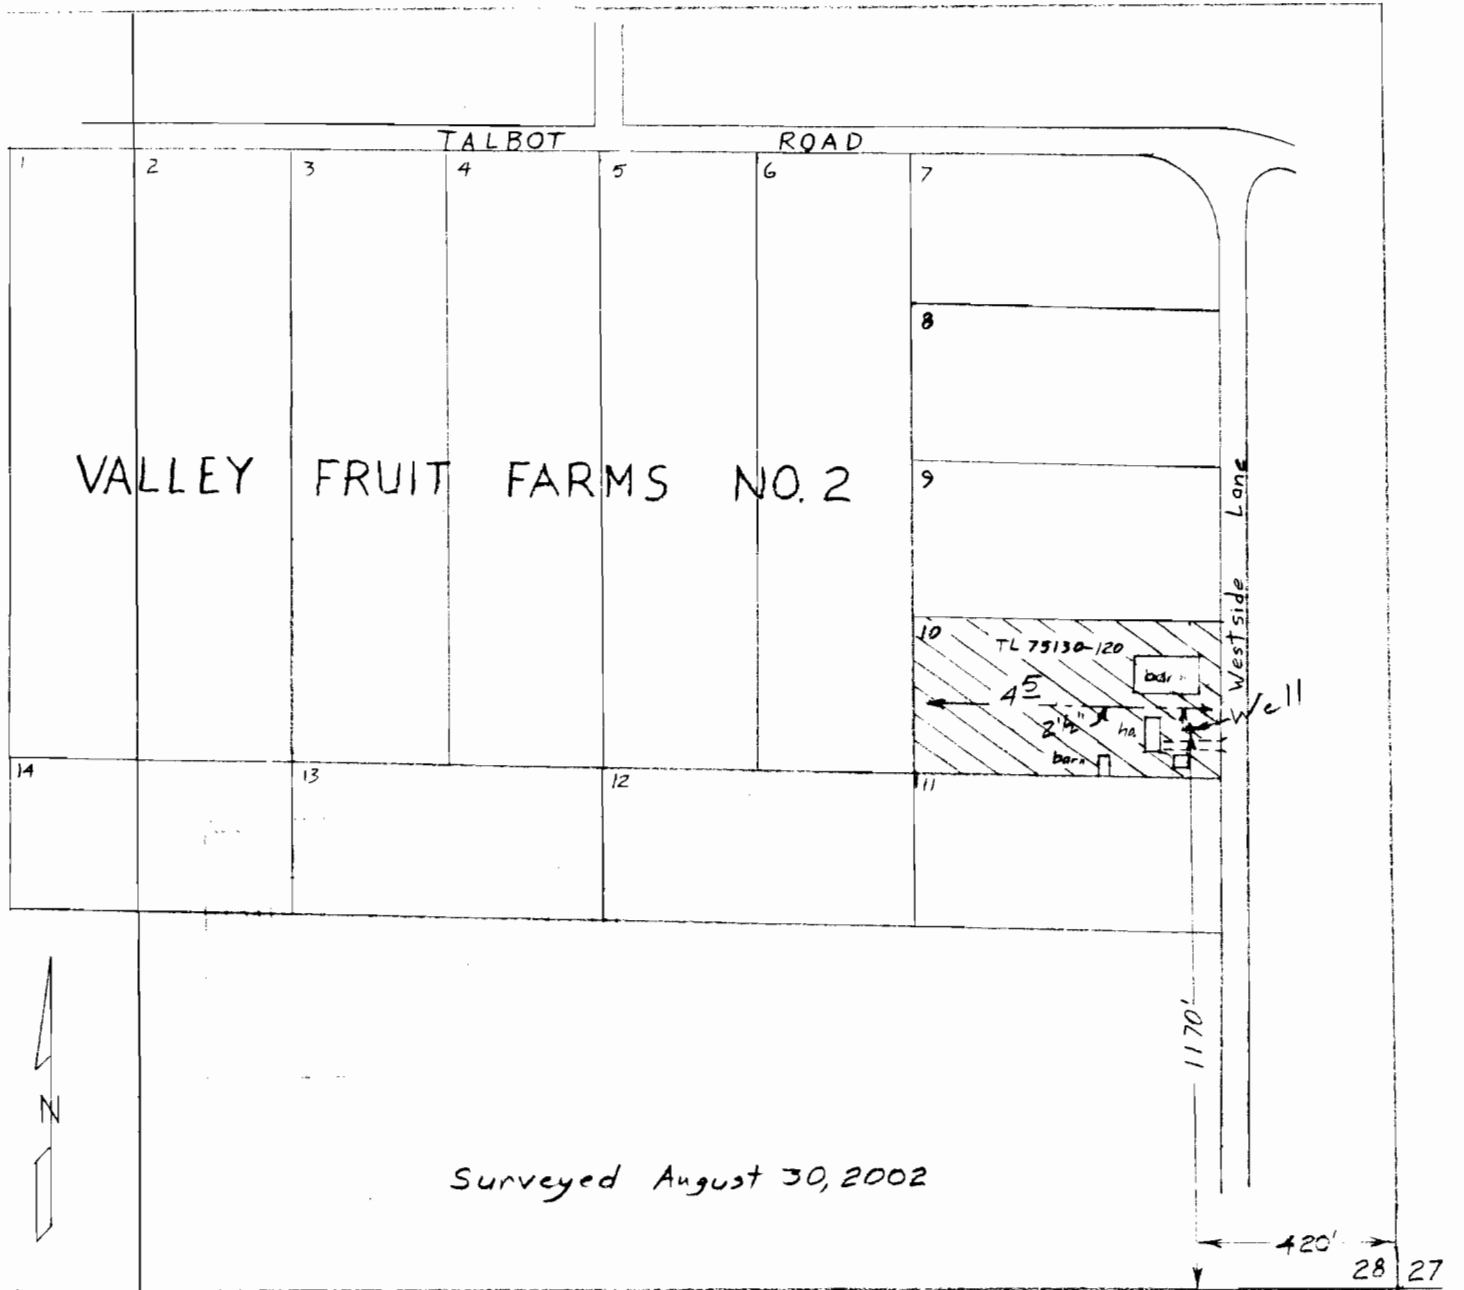


Surveyed August 30, 2002

Claim of Beneficial Use Map
for
JUNO PANDIAN

App G-13900
Per G-13174

This map is for the purpose of
locating a water right only
and has no intent to provide
legal dimensions or the location
of property lines.

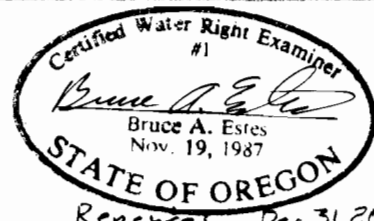

ESTES SURVEYS, LLC
PO Box 17519 60382 Arnold Rd
Salem, OR 97305-7519 Bend, OR 97702
(503) 585-7593 (541) 382-7391