
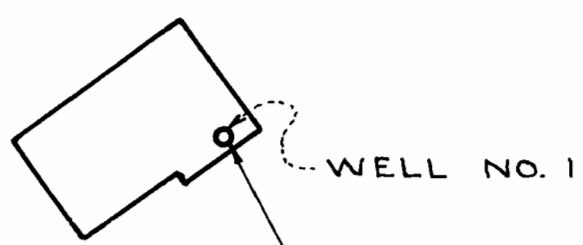


REGISTERED  
 OREGON  
 LAND SURVEYOR  
*W.E. Gillespie*  
 3-30-59  
 MAKE FILE  
 W. E. GILLESPIE  
 344

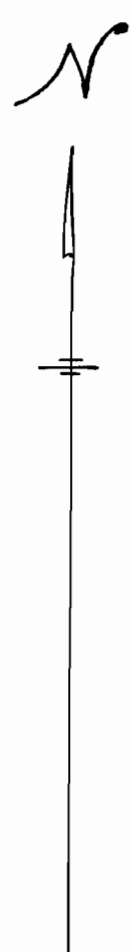

N. 27° 20' W.  
 329.8'

Application No. G-1364  
 Permit No. G-1318

S.E. Cor. SW  $\frac{1}{4}$  SE  $\frac{1}{4}$  Sec. 20 T.18S. R.45E.W.M.

296.8' Iron Pin

APPLICATION FOR PERMIT  
 Dale M. Scheer - Vale, Ore.

Scale 1" = 50'