

Application No. G14326
Permit No. G13191

RECEIVED

UMATILLA COUNTY


1"=200'


JUN 10 1996

WATER RESOURCES DEPT.
SALEM, OREGON

See Map 6N 35 21B

RECEIVED
APR 4 5 1996
WATER RESOURCES DEPT.
SALEM, OREGON

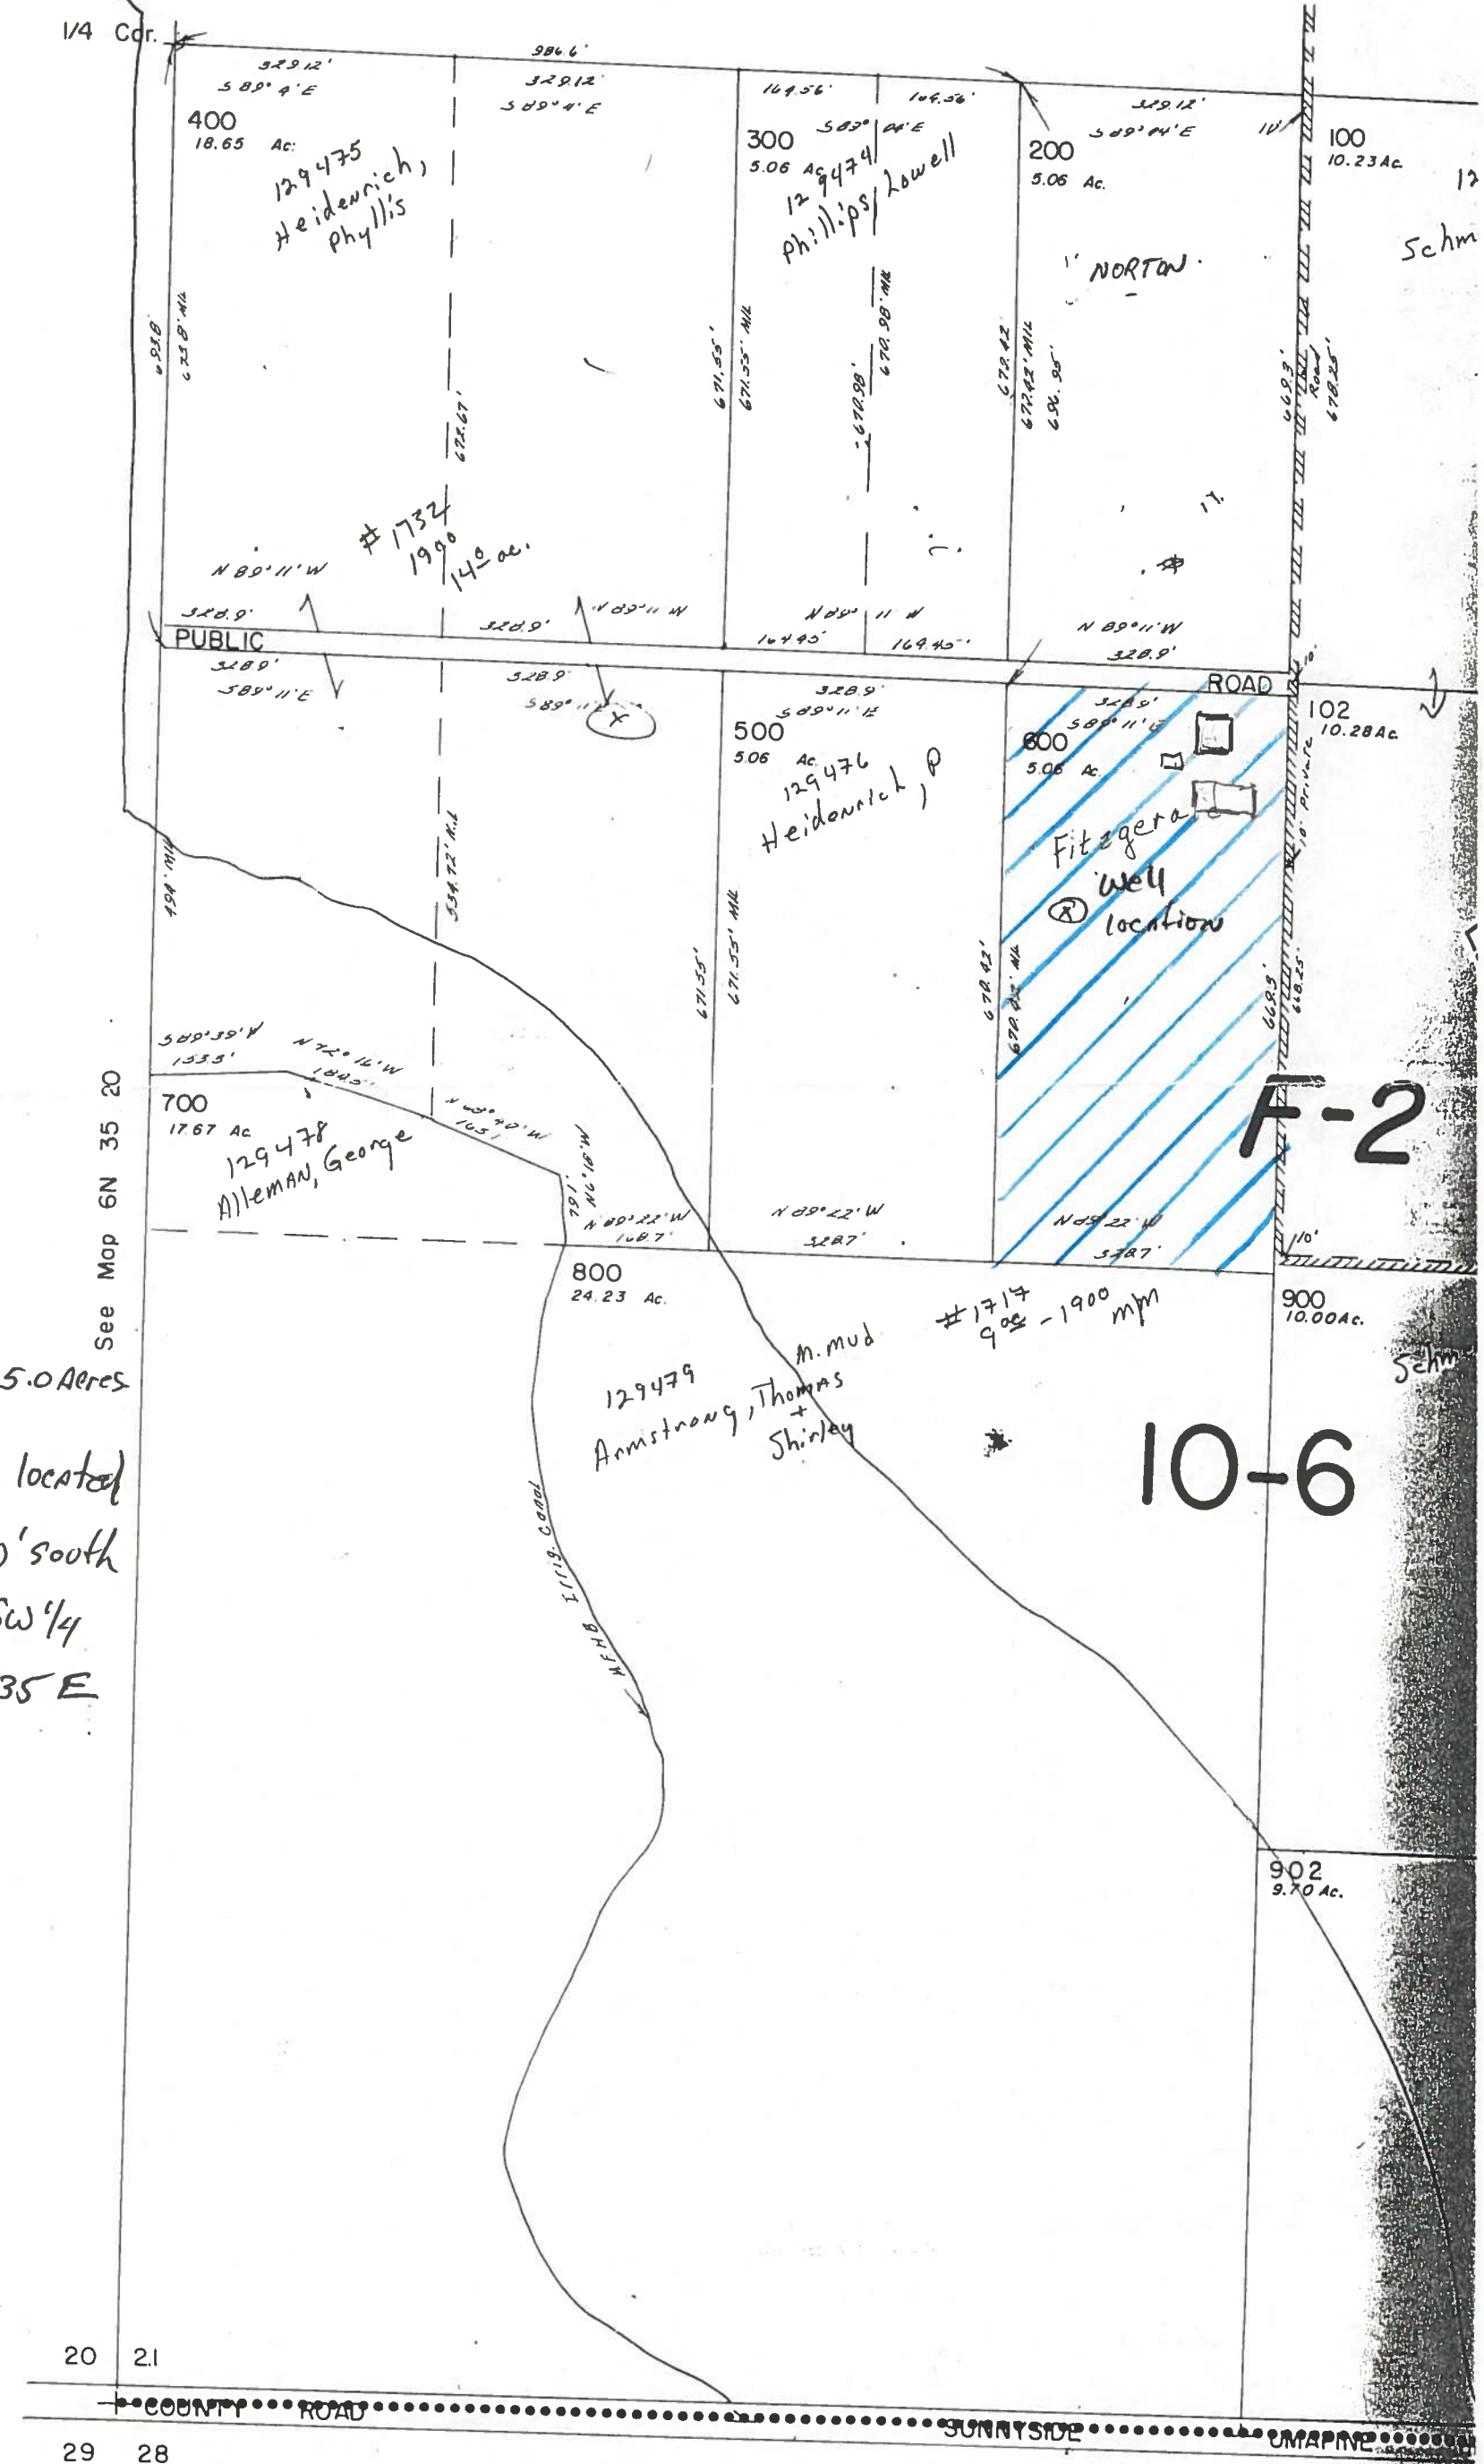

 - lands to be irrigated 5.0 Acres
 Tax lot 600
 Point of diversion is located
 1060' East and 960' south
 of NW 1/4 corner of SW 1/4
 of Sec 21 T6N R35E

RECEIVED
 MAY 24 1996
 WATER RESOURCES DEPT.
 SALEM, OREGON