


T. 6 S. R. 3 W. W.M.

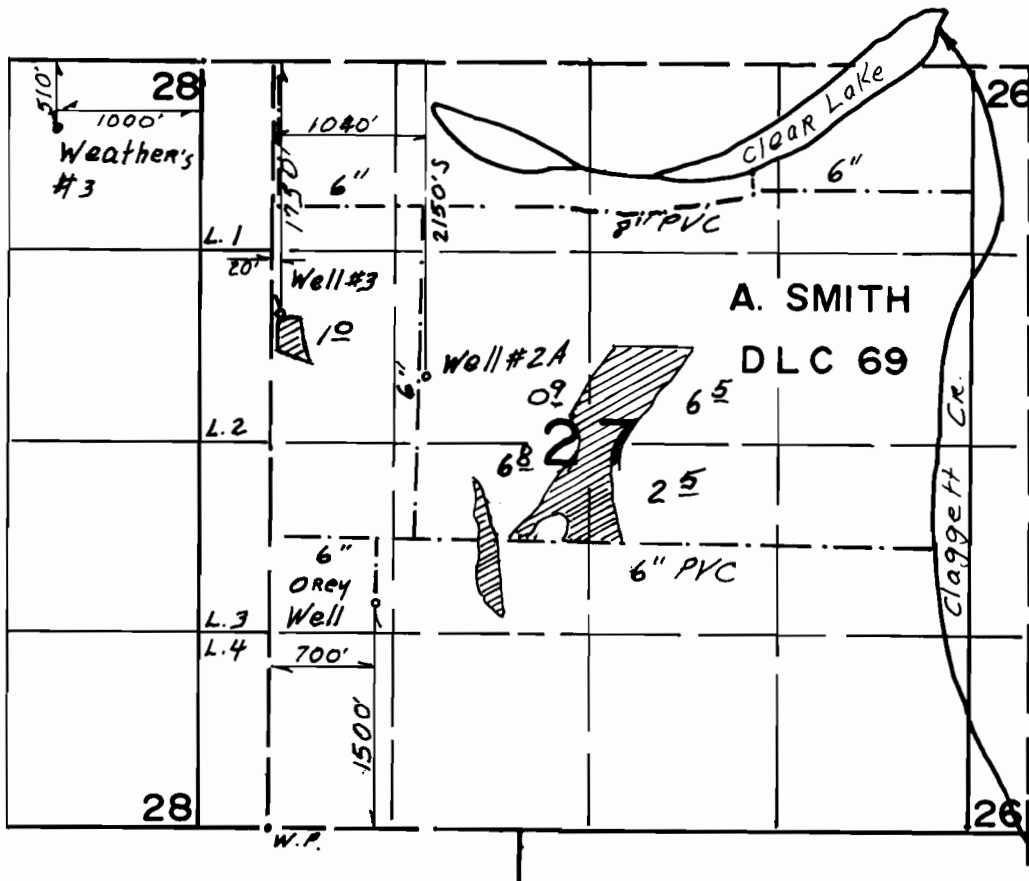

Scale
4" = 1 Mi.


FINAL PROOF SURVEY UNDER

Application No. G-14297 Permit No. G-13194

IN NAME OF

MILLER FOREST, INC.

Surveyed MARCH, 22, '00 by ...

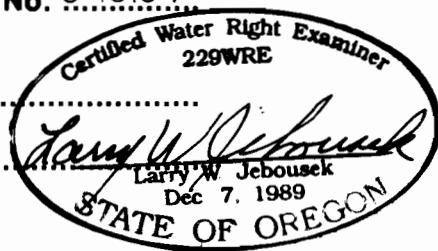

THIS MAP WAS PREPARED FOR THE PURPOSE OF IDENTIFYING THE LOCATION OF A WATER RIGHT ONLY AND IS NOT INTENDED TO PROVIDE LEGAL DIMENSIONS OR LOCATION OF PROPERTY OWNERSHIP LINES.