FINAL PROOF SURVEY MAP IN THE NAME OF WALTER ALLAN CRAM


APPLICATION G - 13171


PERMÍT G - 13197

SECTION 3, TOWNSHIP 28 SOUTH, RANGE 14 WEST, W.M.



1 INCH = 1320 FEET

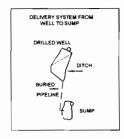

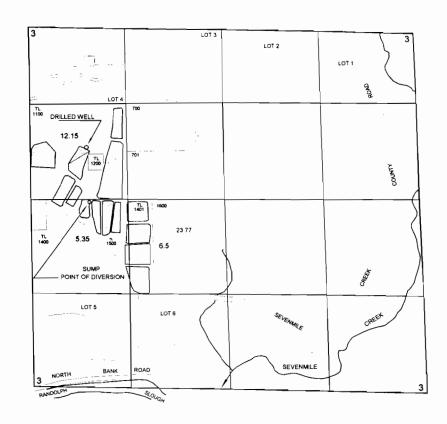

THE POINT OF DIVERSION OF THE DRILLED WELL IS LOCATED 730 FEET NORTH AND 760 FEET EAST; BEING WITHIN THE SW½ NW½; AND

THE POINT OF DIVERSION OF THE SUMP IS LOCATED 30 FEET SOUTH AND 805 FEET EAST; BEING WITHIN THE NW¼ SW½; BOTH

FROM THE WEST QUARTER CORNER OF SECTION 3 AND WITHIN SECTION 3, TOWNSHIP 28 SOUTH, RANGE 14 WEST, W.M., COOS COUNTY.

