


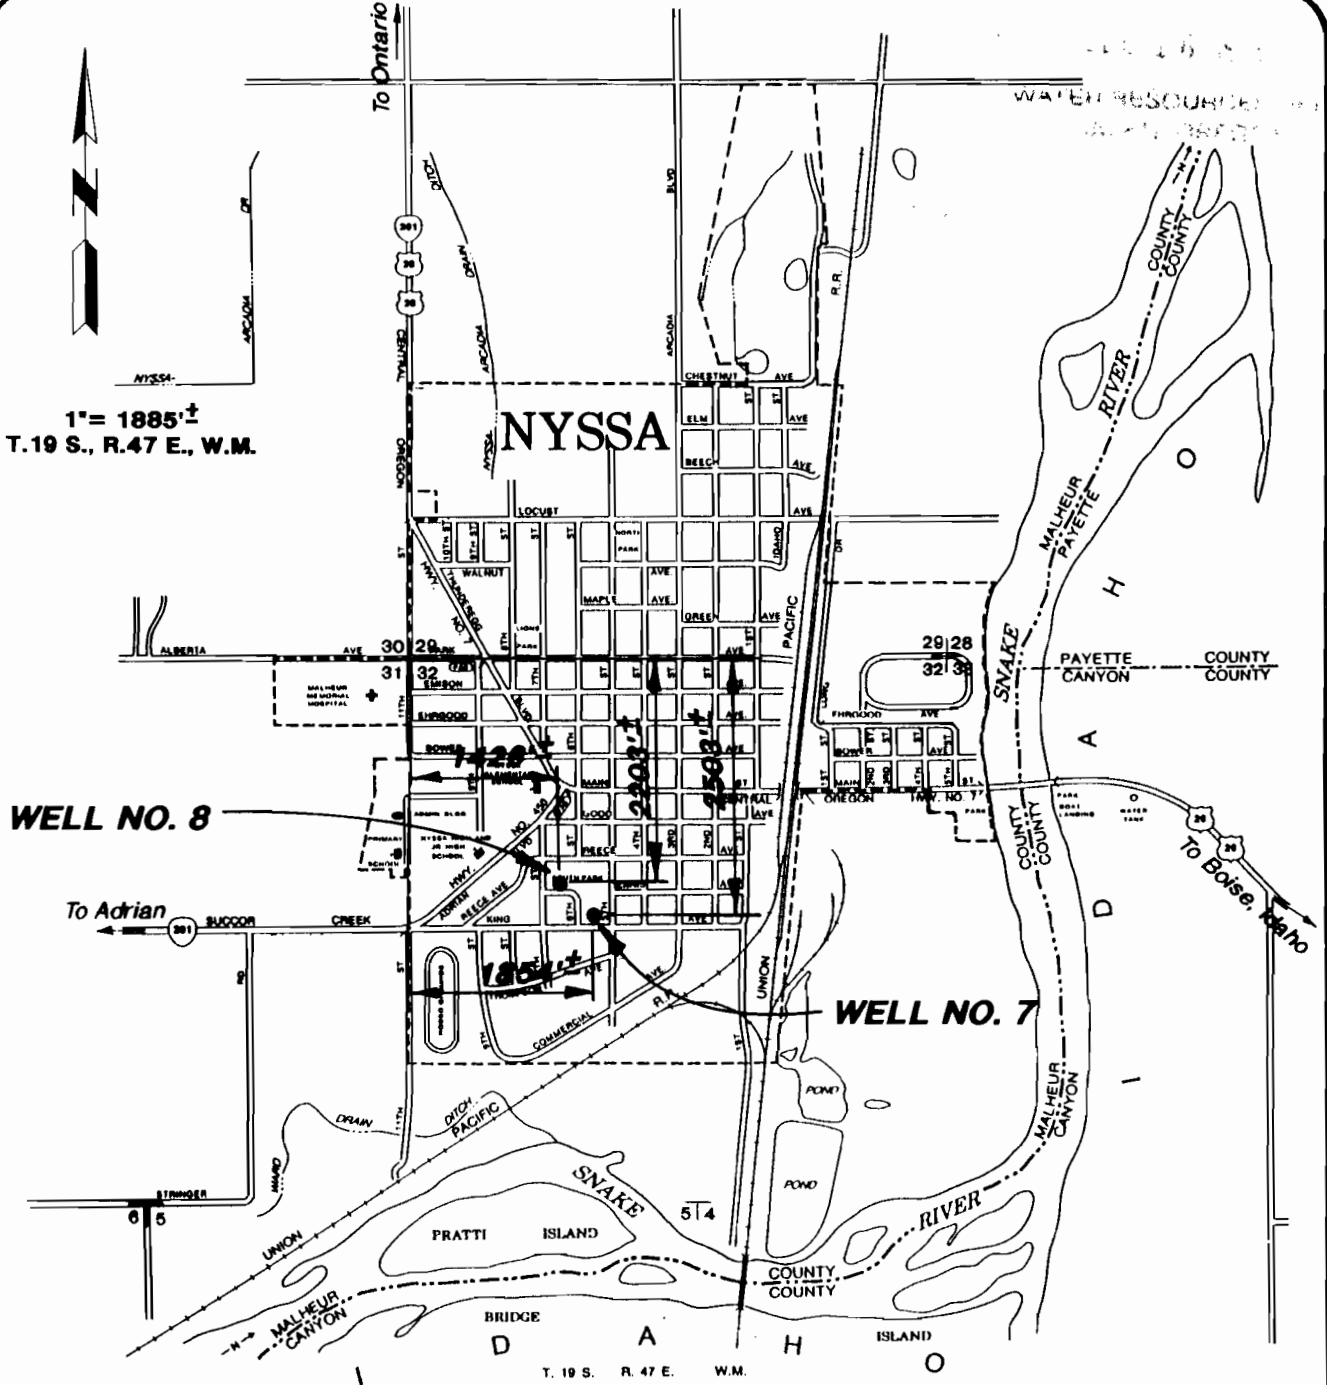


1" = 1885'
T. 19 S., R. 47 E., W.M.

WELL NO. 8

WELL NO. 7



Certified Water Right Examiner
#111
Allen C. Rieka
Allen C. Rieka
Nov. 19, 1967
STATE OF OREGON
EXPIRES 12-31-98

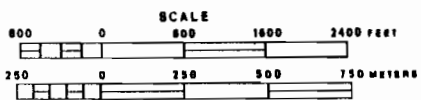

Application No. G-12298
Permit No. ~~G-13202~~

CITY OF
NYSSA, OREGON
WATER RIGHTS APPLICATION
NO. G-12298
WELL LOCATION MAP

G-13202
FIGURE

