


T. 5 & 6 S., R. 2 W., W.M.

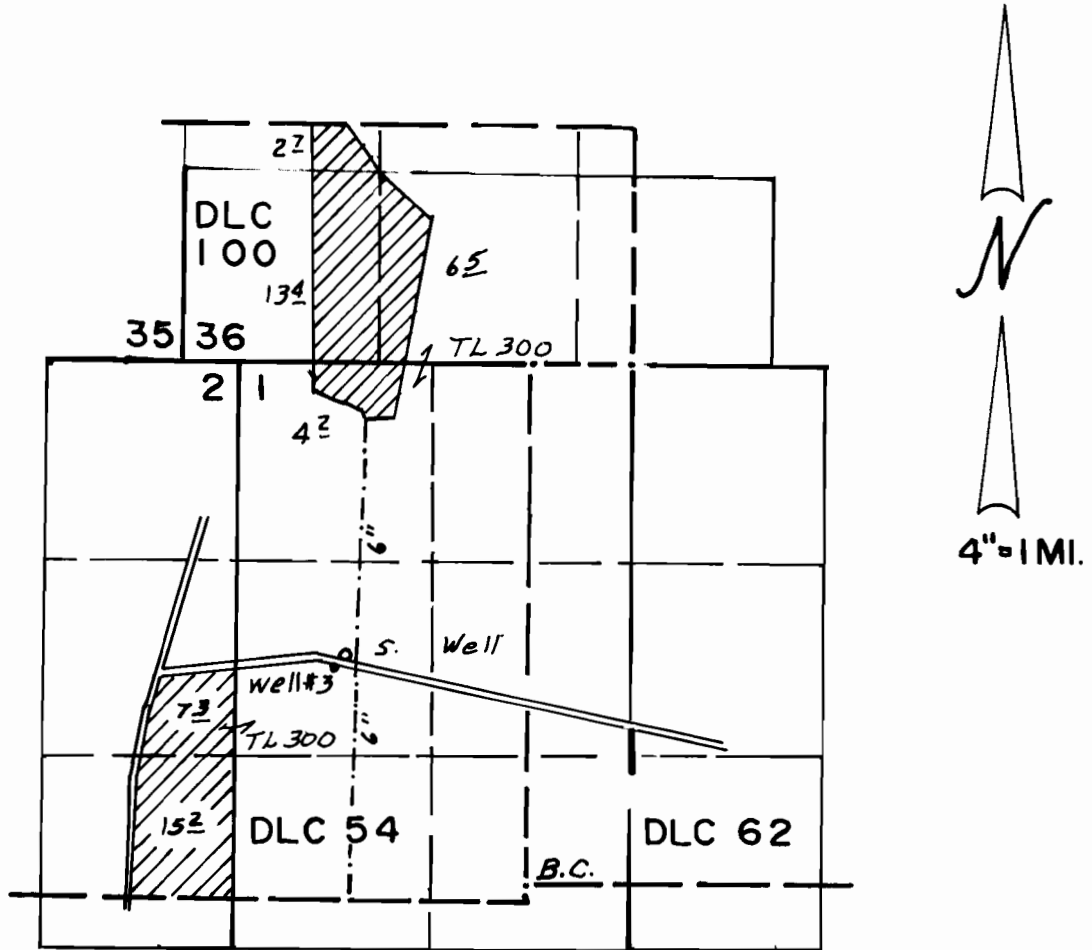


S. Well Loc. 1580' N. & 1250' W. From SW Cor. DLC 62
 Well #3 Loc. 1450' N. & 1300' W. " " " " " "

FINAL PROOF SURVEY UNDER

Application No. G-14722 Permit No. G-13206
 IN NAME OF

.....VALENTINE MILLER.....

Surveyed June 17, 2002, by

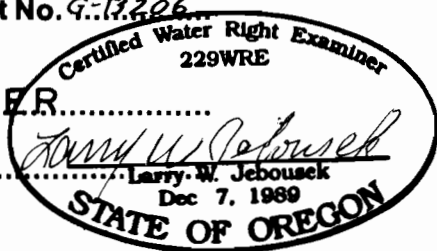

THIS MAP WAS PREPARED FOR THE PURPOSE OF IDENTIFYING THE LOCATION OF A WATER RIGHT ONLY AND IS NOT INTENDED TO PROVIDE LEGAL DIMENSIONS OR LOCATION OF PROPERTY OWNERSHIP LINES.