


NW1/4, SECTION 9, TWP.2 N. RANGE 10 E. W.M.  
 HOOD RIVER COUNTY, OREGON

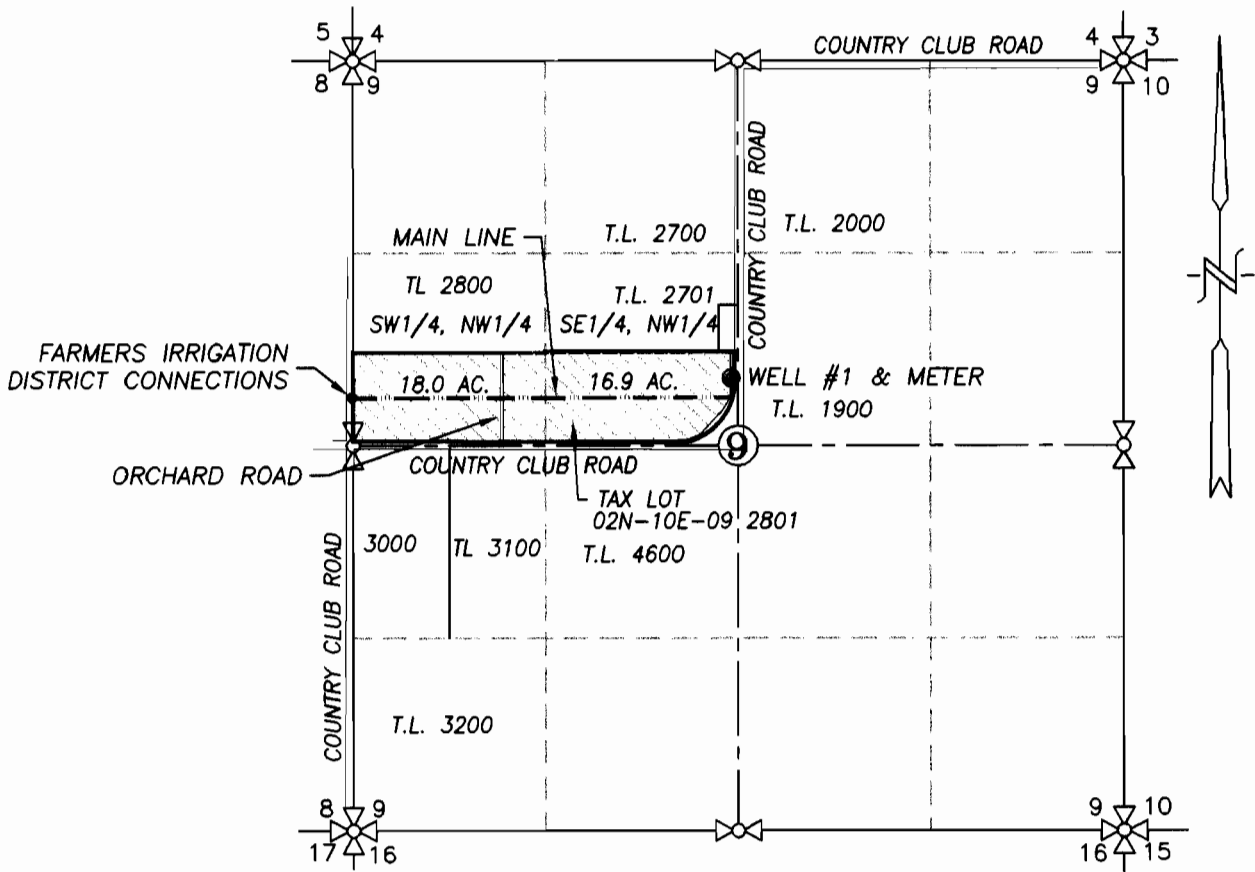

**RECEIVED  
 OVER THE COUNTER**

- EXISTING WELL, 50' W. & 2175' S. OF N1/4 COR. SEC. 9
- ▭ APPLICATION AREA = 34.9 ACRES
- EXISTING IRRIGATION MAIN

**RECEIVED**

AUG 30 2007

WATER RESOURCES DEPT  
 SALEM, OREGON

**CLAIM OF BENEFICIAL USE MAP**

SCALE: 1" = 1320'

APPLICATION No. G-14319

PERMIT No. G-13207

IN THE NAME OF:  
ANDY VON FLOTOW

DATE: AUGUST 22, 2007



EXPIRES: 06/30/08

BY: **TENNESON ENGINEERING CORP.**  
 409 LINCOLN STREET,  
 THE DALLES, OREGON. 97058  
 PH. (541) 296-9177  
 FAX (541) 296-6657



**NOTE:**

"THIS MAP IS NOT INTENDED TO  
 PROVIDE DIMENSIONS OR LOCATIONS  
 OF PROPERTY OWNERSHIP LINES."

W.O. #12544wr