
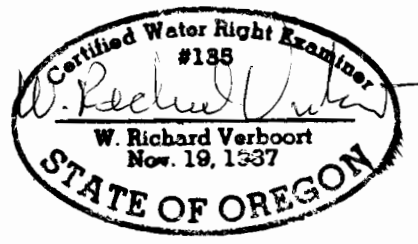


SECTION 4, T.2S., R.2W., W.M.
 WASHINGTON COUNTY, OREGON

N.W. COR.
 DLC 41

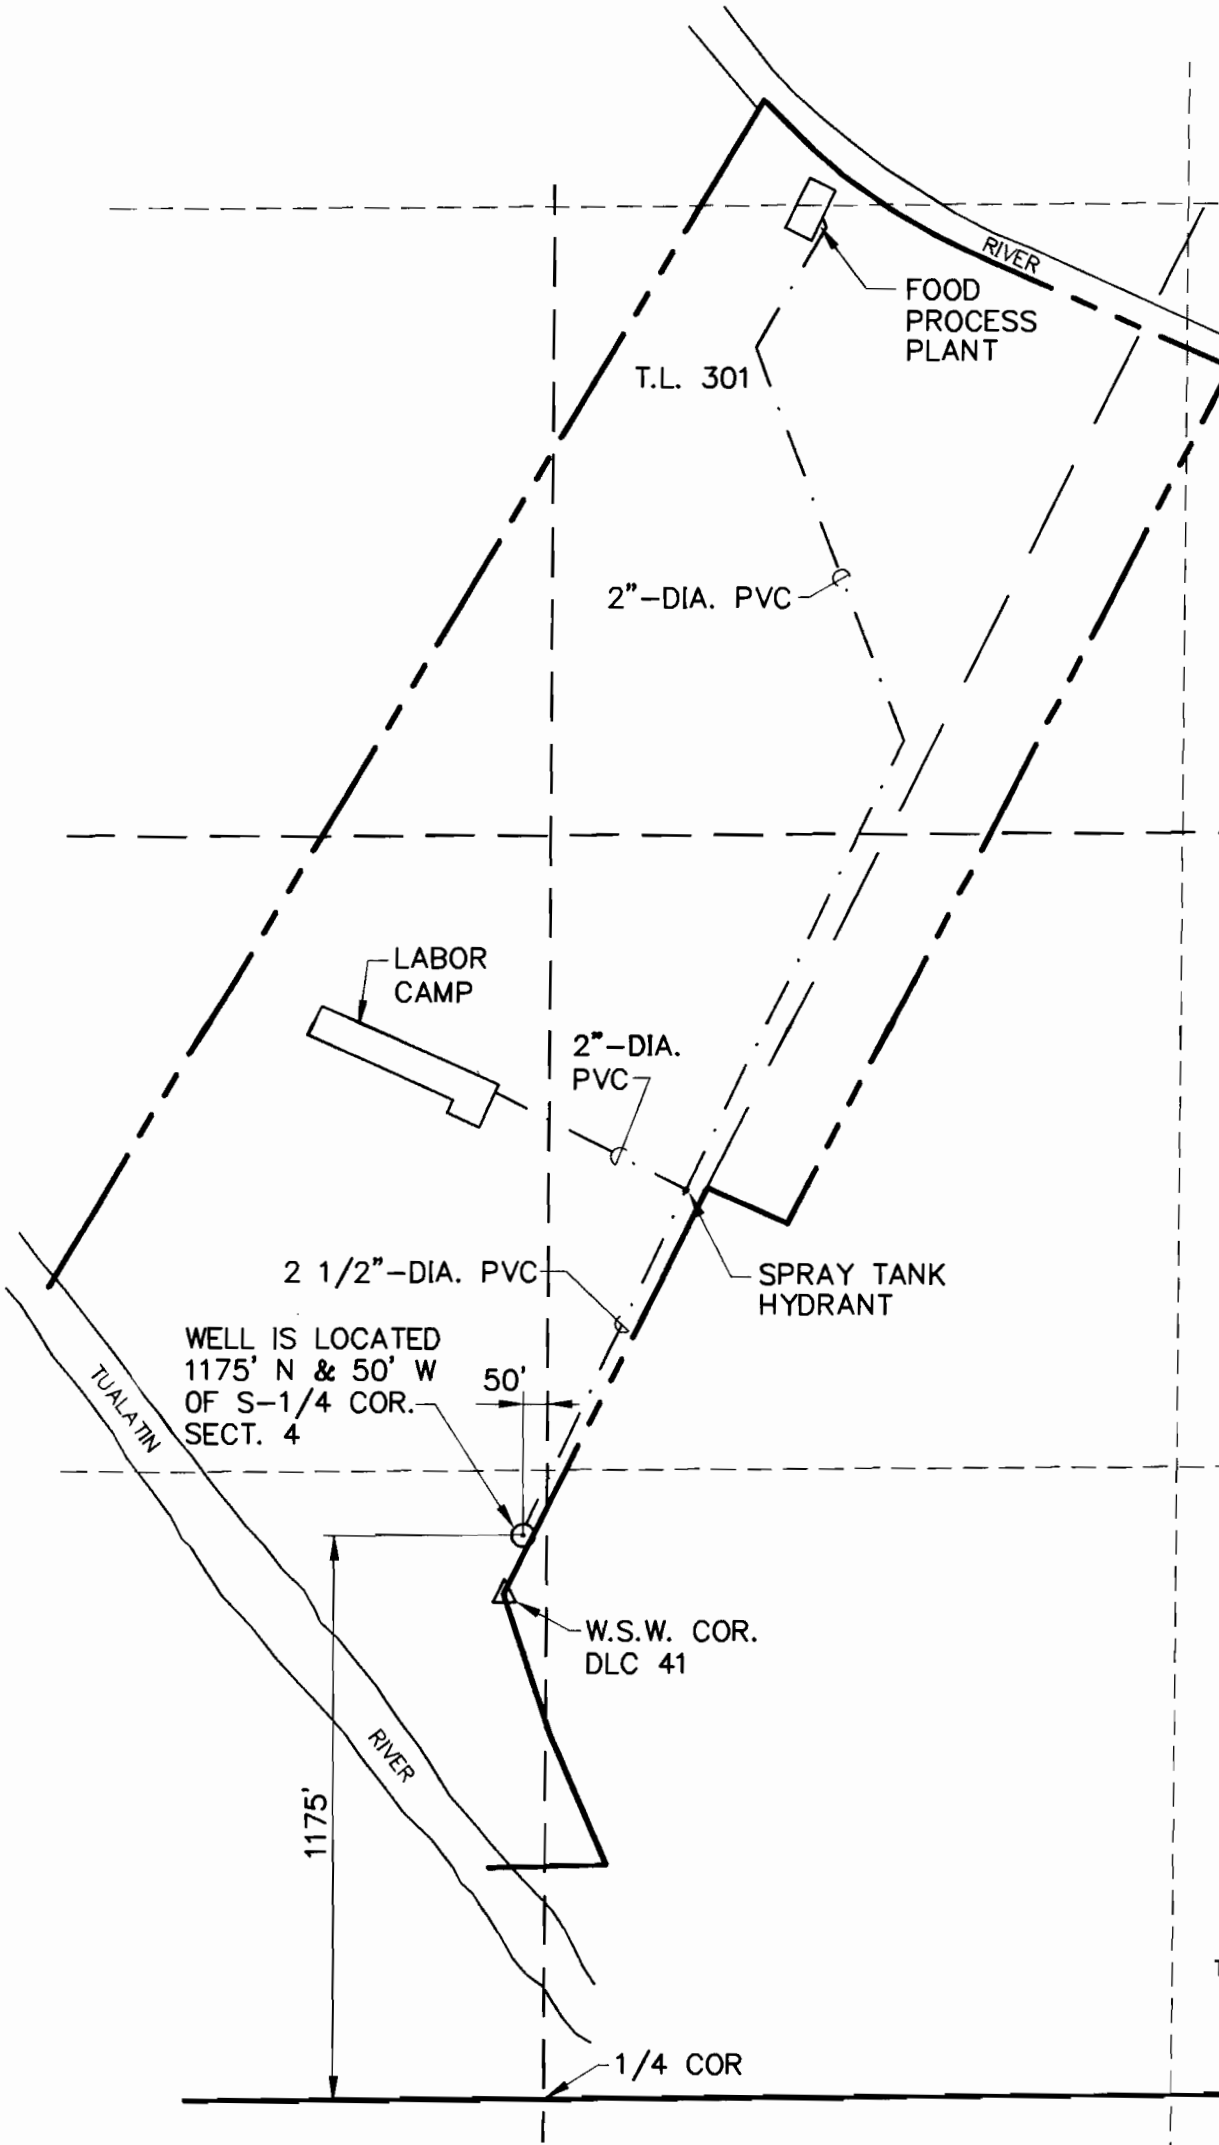

SCALE: 1"=400'

MAP BASE:
 ASSESSORS MAP
 2000 SCALED PHOTO

FINAL PROOF SURVEY
 UNDER

APPLICATIONS PERMITS
 G-12227 G-13211

SURVEYED AUGUST 29, 2002

PREPERATION OF THIS MAP IS FOR THE
 PURPOSE OF IDENTIFYING THE LOCATION OF
 THE WATER RIGHT ONLY. THERE IS NO INTENT
 TO PROVIDE DIMENSIONS OR LOCATION OF
 PROPERTY OWNERSHIP LINES.

4 3
 9 10

VERBOORT ENGINEERING
 AGRICULTURE · CIVIL · WATER RESOURCES
 HILLSBORO, OREGON

	by	date
designed	<u>WRV</u>	<u>09/04/02</u>
drawn	<u>JER</u>	<u>09/04/02</u>
checked	<u>WRV</u>	<u>09/04/02</u>
drawing no.	<u>02-B-08</u>	
sheet no.	<u>1 / 1</u>	

DECKER FARMS, INC.
 12475 S.W. RIVER ROAD
 HILLSBORO, OR