


T. 9 S. R. 3 W. W.M.

RECEIVED

OCT 02 1996

WATER RESOURCES DIV.
STATE OF OREGON

Application No. *B-14389*
Permit No.

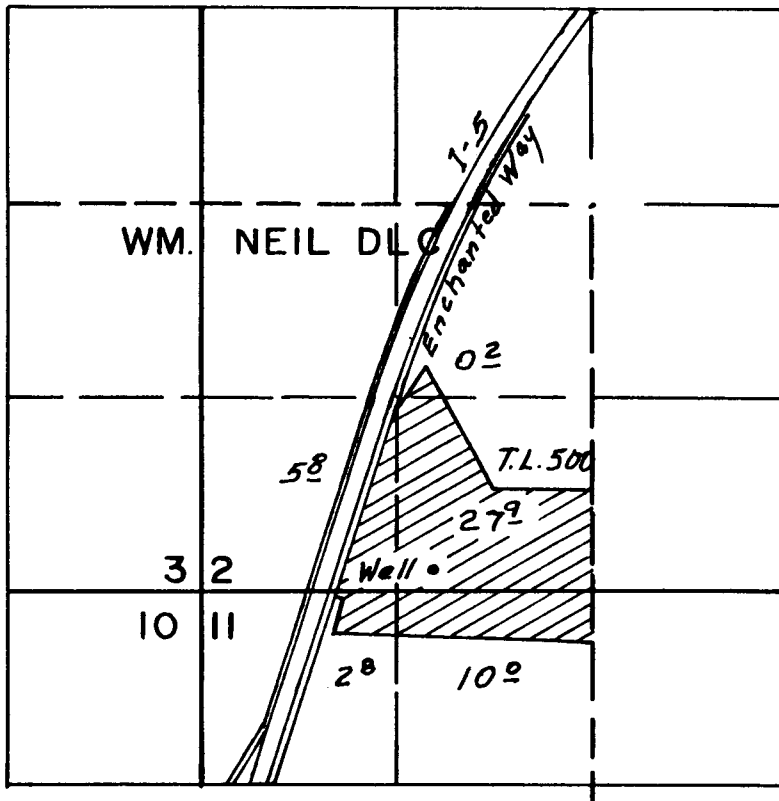

Scale
4" = 1 Mi.

Well Loc. 140' N & 1070' W from S $\frac{1}{4}$ Cor Sec. 2

WATER RIGHTS MAP FOR
MT. JEFFERSON FARMS

THIS MAP WAS PREPARED FOR THE PURPOSE OF IDENTIFYING THE LOCATION OF A WATER RIGHT ONLY AND IS NOT INTENDED TO PROVIDE LEGAL DIMENSIONS OR LOCATION OF PROPERTY OWNERSHIP LINES.

